


DATE 6/11/96

TOWN OF LEXINGTON — BOARD OF PUBLIC WORKS
SEWER DIVISION

Sketch of Service Here

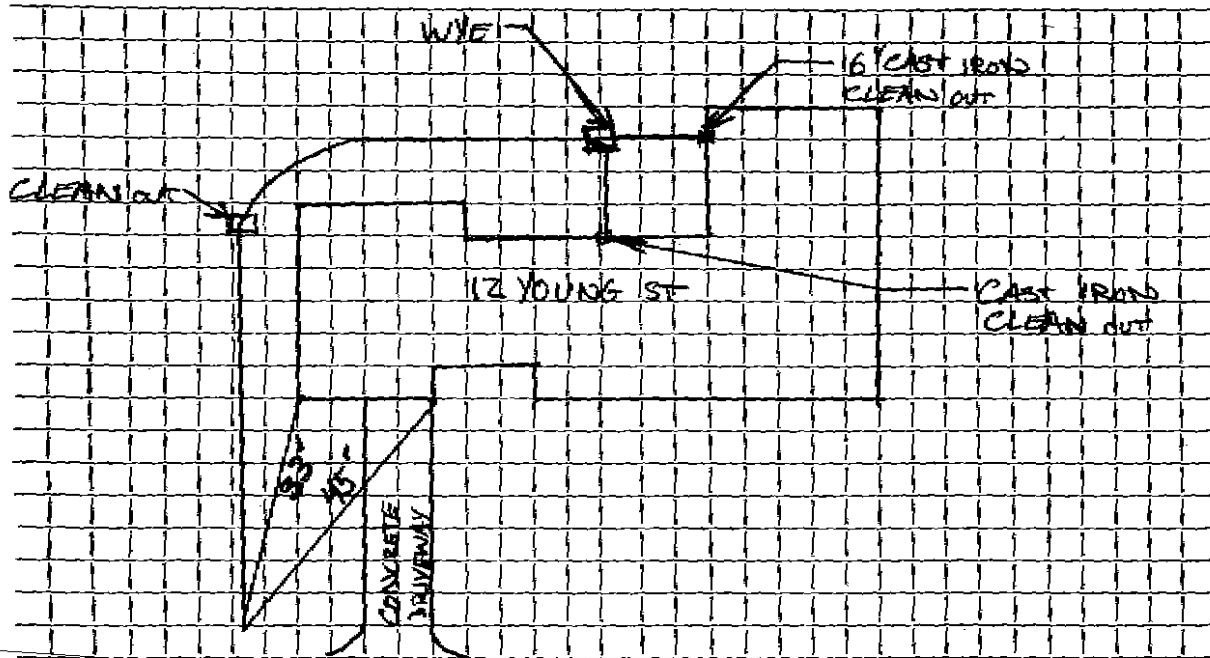

Connection made in Street. Work completed

Remarks:

.....

Name Lester Zieff

Service No.

Address 12 Young St.

Location

Kind of Pipe ACP

Size 6"

Size of Main 8"

Repair—Renewal—New Service

Location

Date

Material

Amount

Total

Date

Amount

8-15 73

23' 0" 9.00


207.00

DATE _____

TOWN OF LEXINGTON — BOARD OF PUBLIC WORKS

SEWER DIVISION

Sketch of Service Here

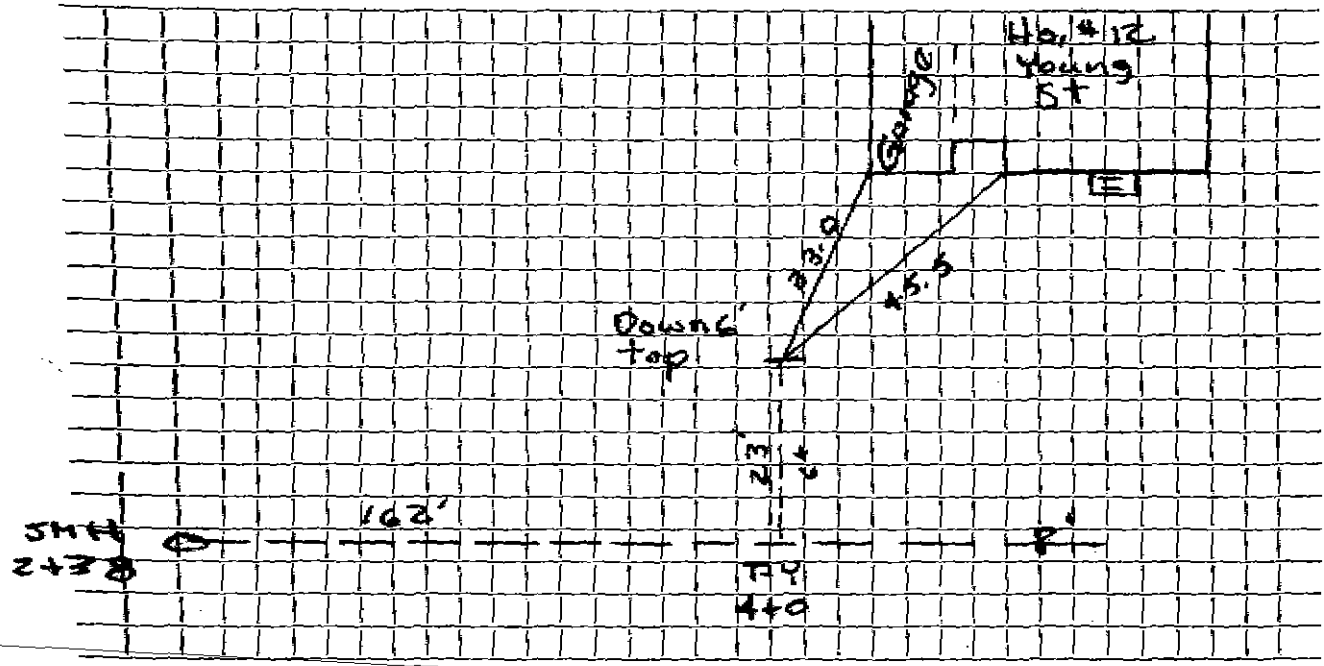

Connection made in Young St. Street. Work completed

Remarks:

.....

.....