

Name Robert L. Frissore

Service No. 196

Address ¹⁶ Young St.

Location

Kind of Pipe ACP

Size 6"

Size of Main 8"

Repair—Renewal—New Service DeFlice Bros. # 2449

Location APR 8 1974


Date	Material	Amount	Total	Date	Amount
8-15	73 26' @ 9.00	234.00		12-5-73	Deposit
12-	73 25'-6" ACP				
	10'-4" CI				

DATE _____

TOWN OF LEXINGTON — BOARD OF PUBLIC WORKS

SEWER DIVISION

Sketch of Service Here

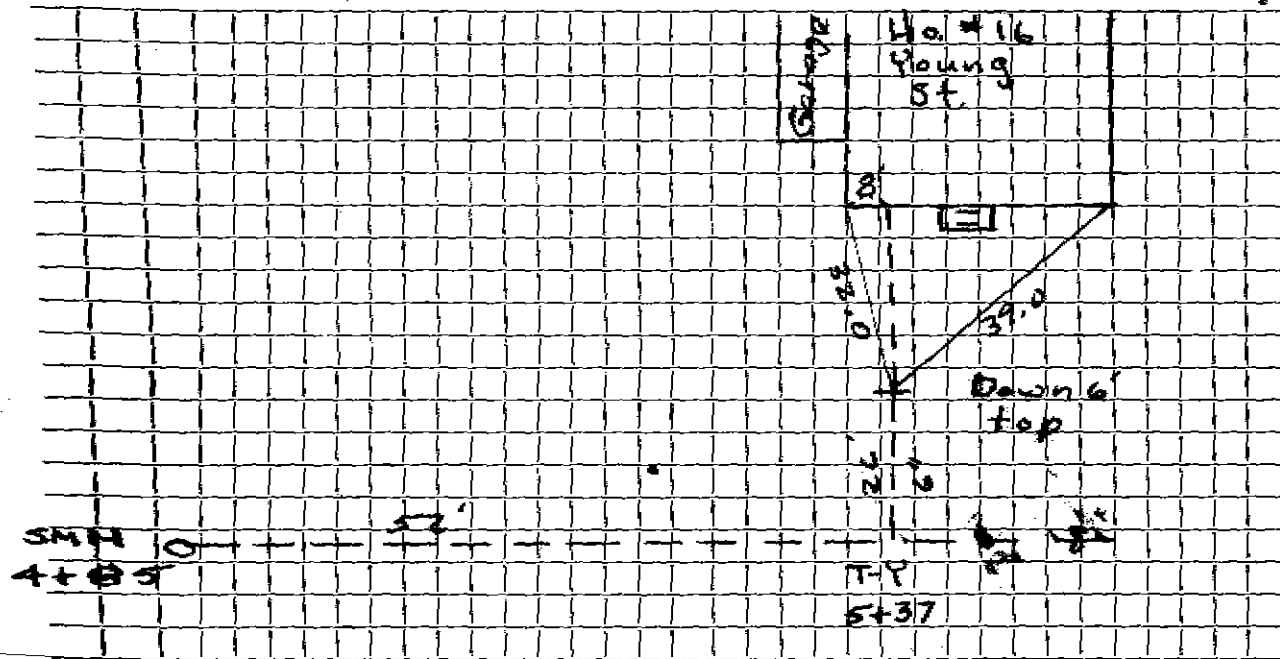

Connection made in Young St. Street. Work completed

Remarks:

.....

.....