




DATE SEPT 30 1997

TOWN OF LEXINGTON — BOARD OF PUBLIC WORKS  
SEWER DIVISION

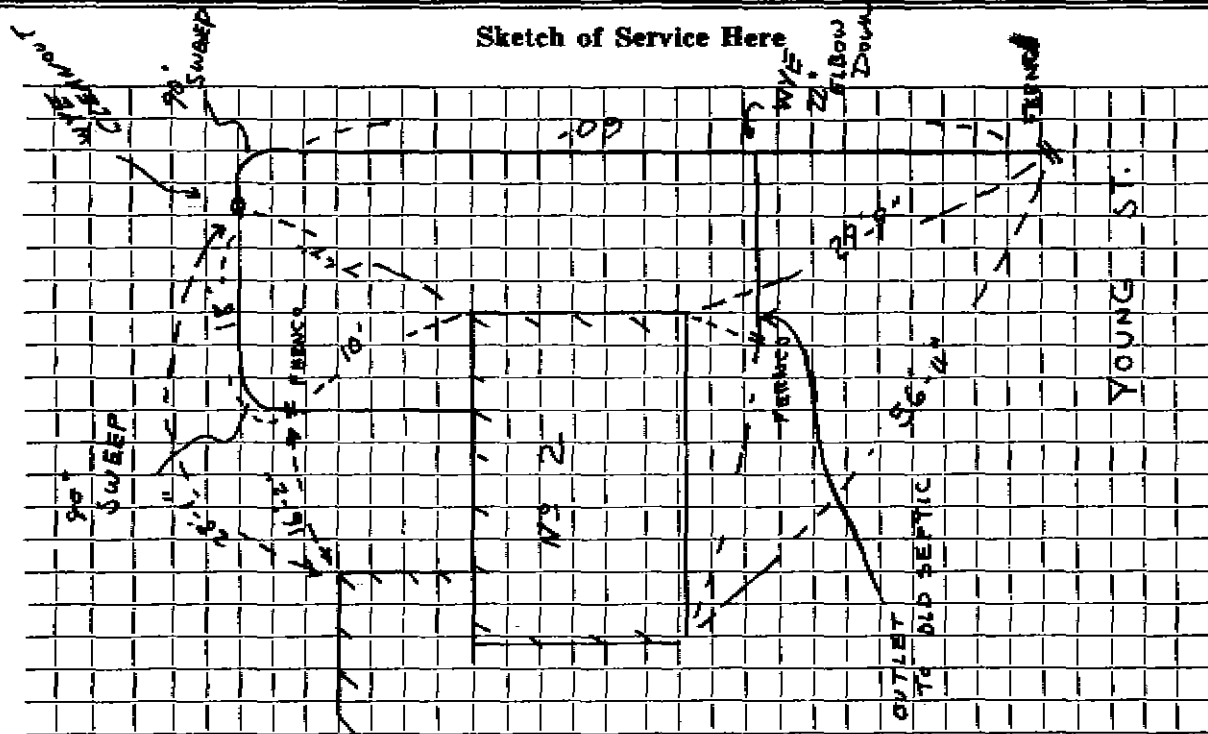

Connection made in YOUNG Street. Work completed ROCKWELL CONST.

Remarks: .....

..... FIELD BOOK 97-1 ..... TJM .....

Name

Service No.

Address *2 Young St.*

Location

Kind of Pipe *ACP*

Size *6"*

Size of Main *8"*

Repair—Renewal—New Service

Location


Date	Material	Amount	Total	Date	Amount
<i>8-17 73</i>	<i>23' @ 9.00</i>	<i>207.00</i>			

DATE \_\_\_\_\_

# TOWN OF LEXINGTON — BOARD OF PUBLIC WORKS

## SEWER DIVISION

Sketch of Service Here

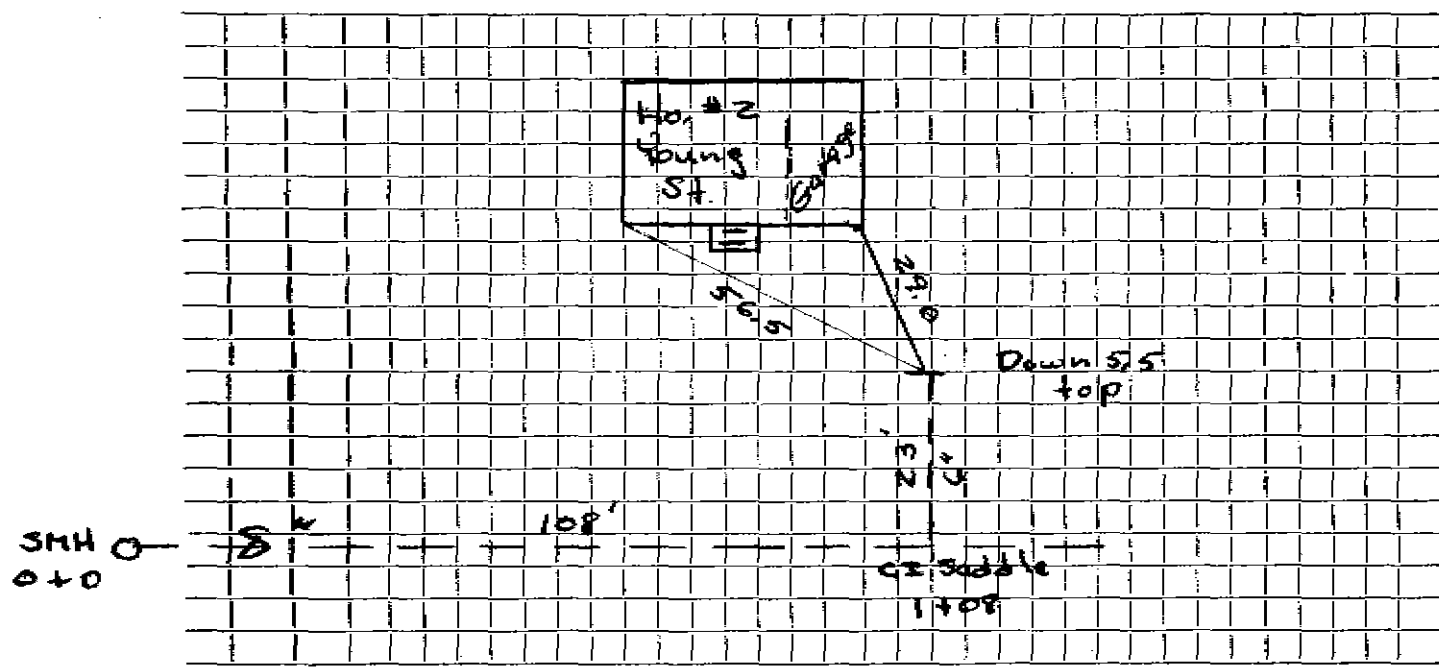

Connection made in Young St. Street. Work completed .....

Remarks: .....  
.....  
.....