




TOWN OF LEXINGTON — BOARD OF PUBLIC WORKS

SEWER DIVISION

DATE \_\_\_\_\_

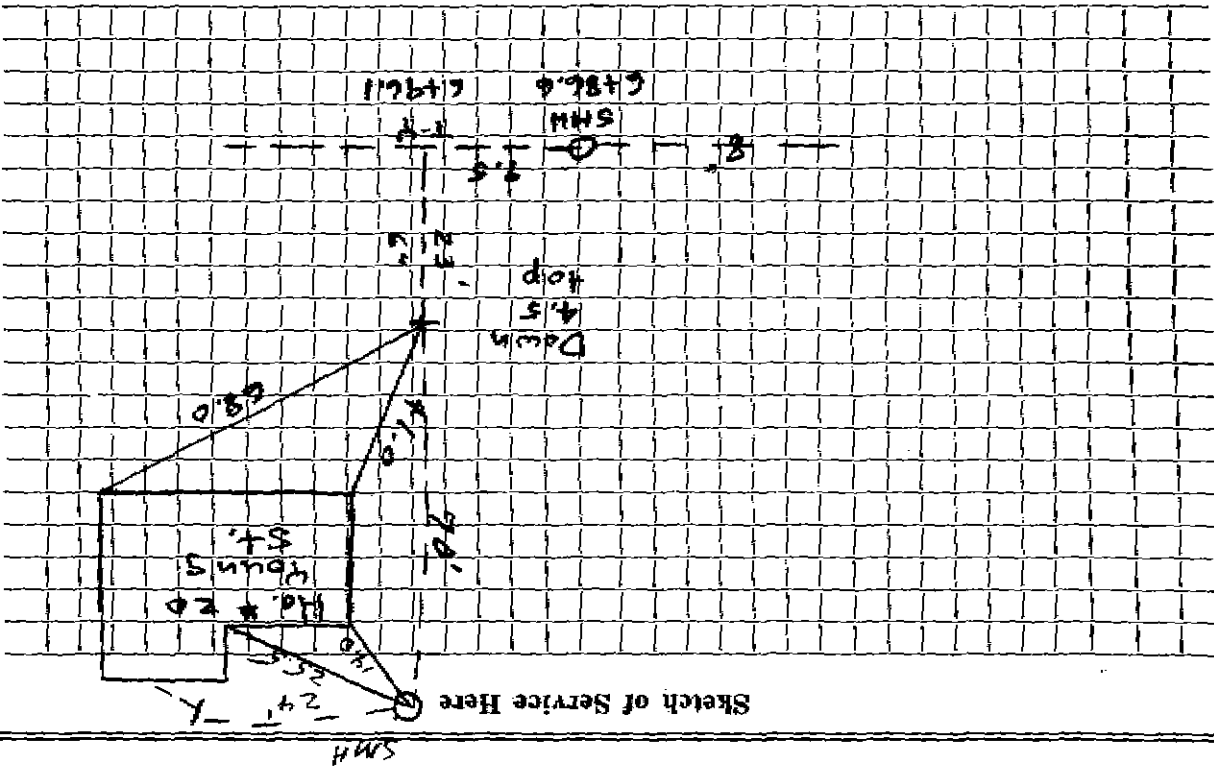

Sketch of Service Here

Connection made in Jones St. Street. Work completed.

Remarks: