


Remarks:

Connection made in Street: *28 Young St*

Work completed *Oct 7, 1974*

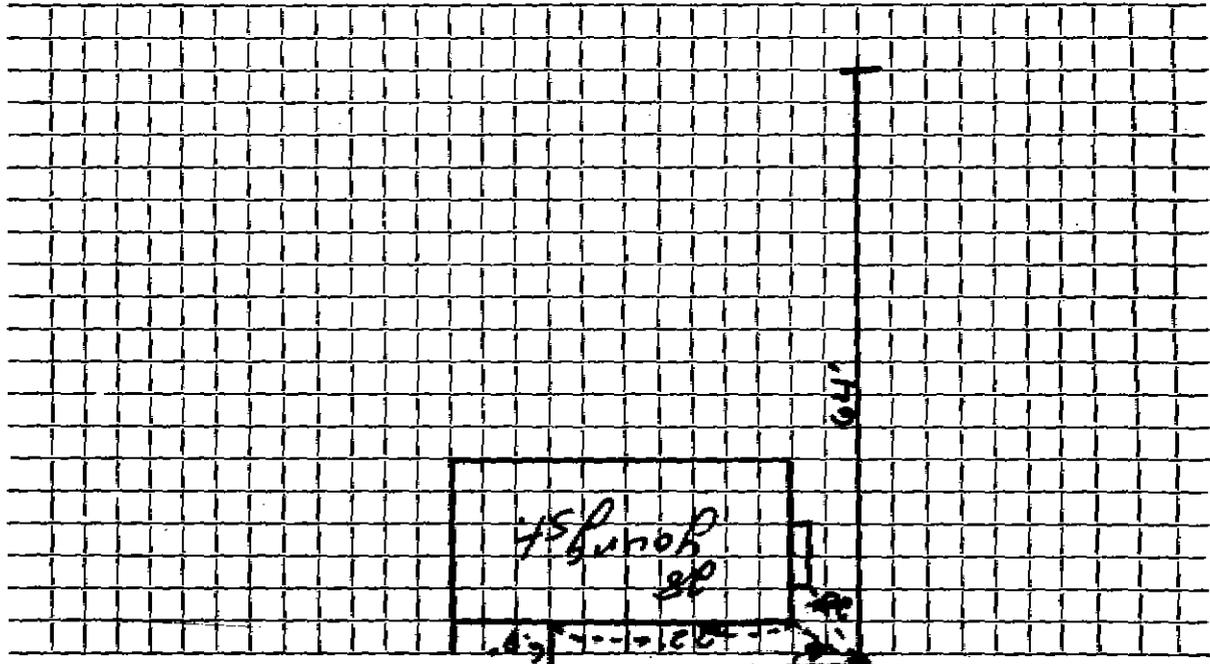

Sketch of Service Here

SEWER DIVISION

TOWN OF LEXINGTON — BOARD OF PUBLIC WORKS

DATE *8-10-74*