




TOWN OF LEXINGTON — BOARD OF PUBLIC WORKS

SEWER DIVISION

Sketch of Service Here

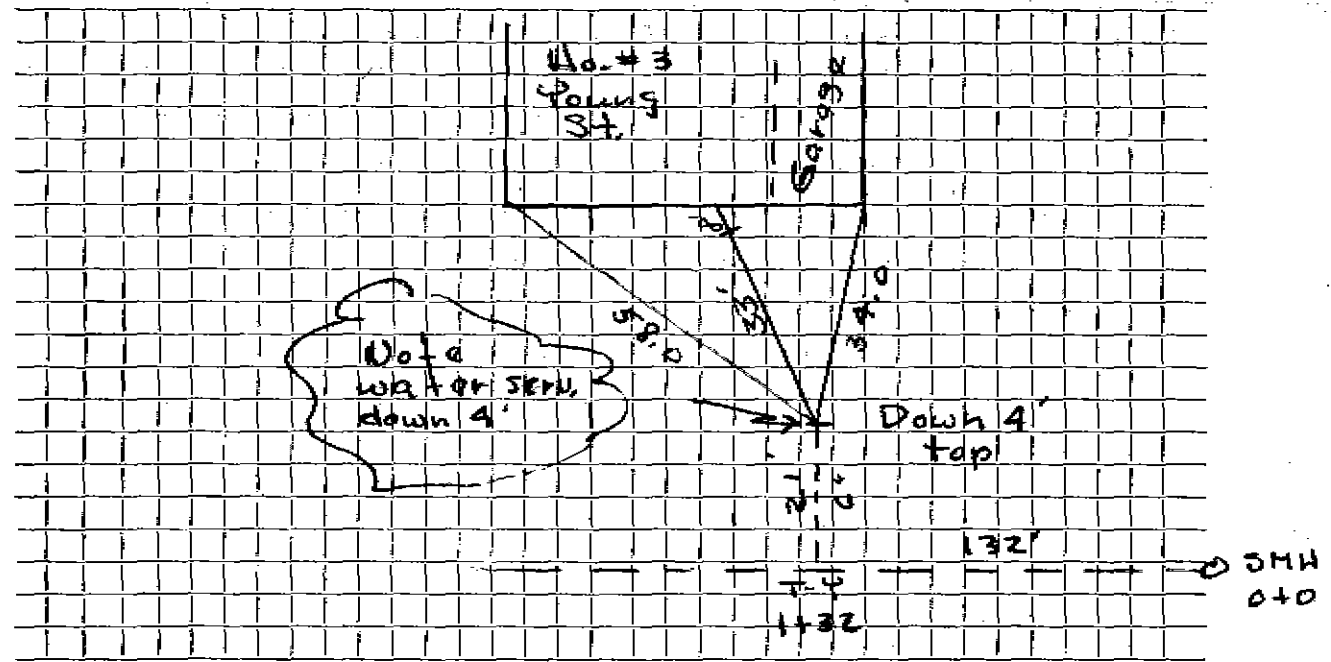

Connection made in Young St. Street. Work completed .....

Remarks: Water & Sewer in same trench .....

.....  
.....