


DATE 7-22-74

TOWN OF LEXINGTON — BOARD OF PUBLIC WORKS

SEWER DIVISION

Sketch of Service Here

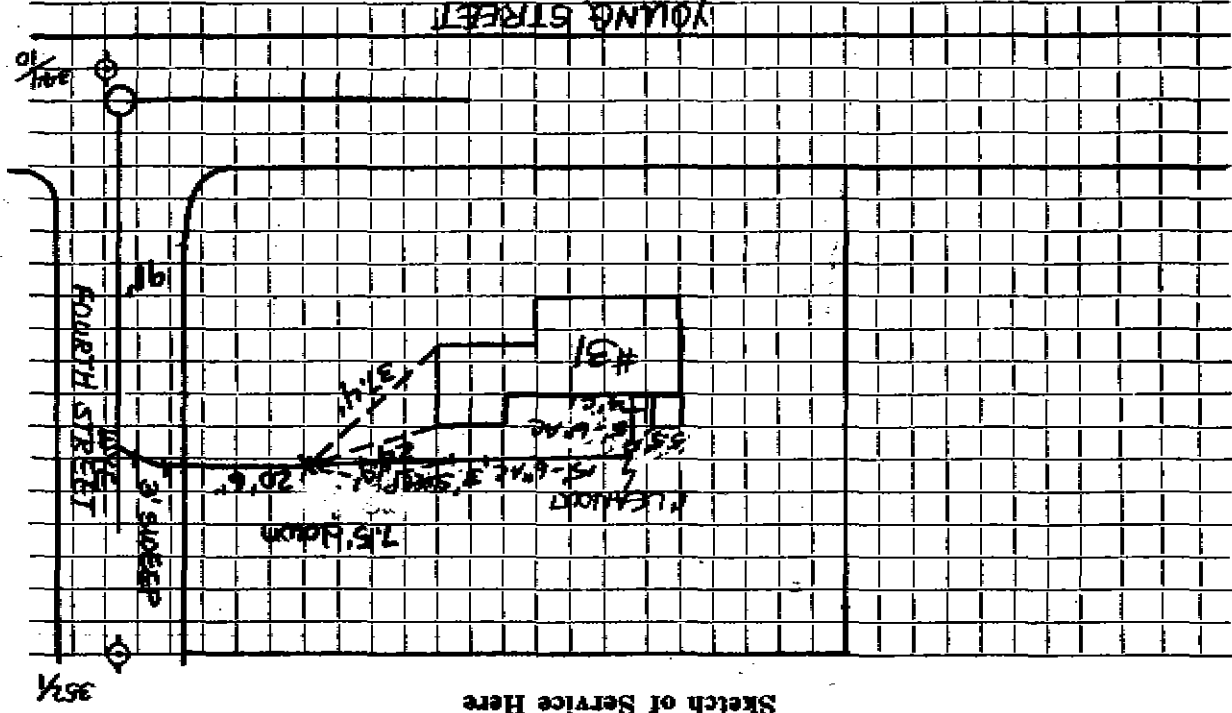

Connection made in **FOURTH** Street. Work completed 8-24-74

Remarks: