




DATE \_\_\_\_\_

TOWN OF LEXINGTON — BOARD OF PUBLIC WORKS  
SEWER DIVISION

Sketch of Service Here

#32 Young St.

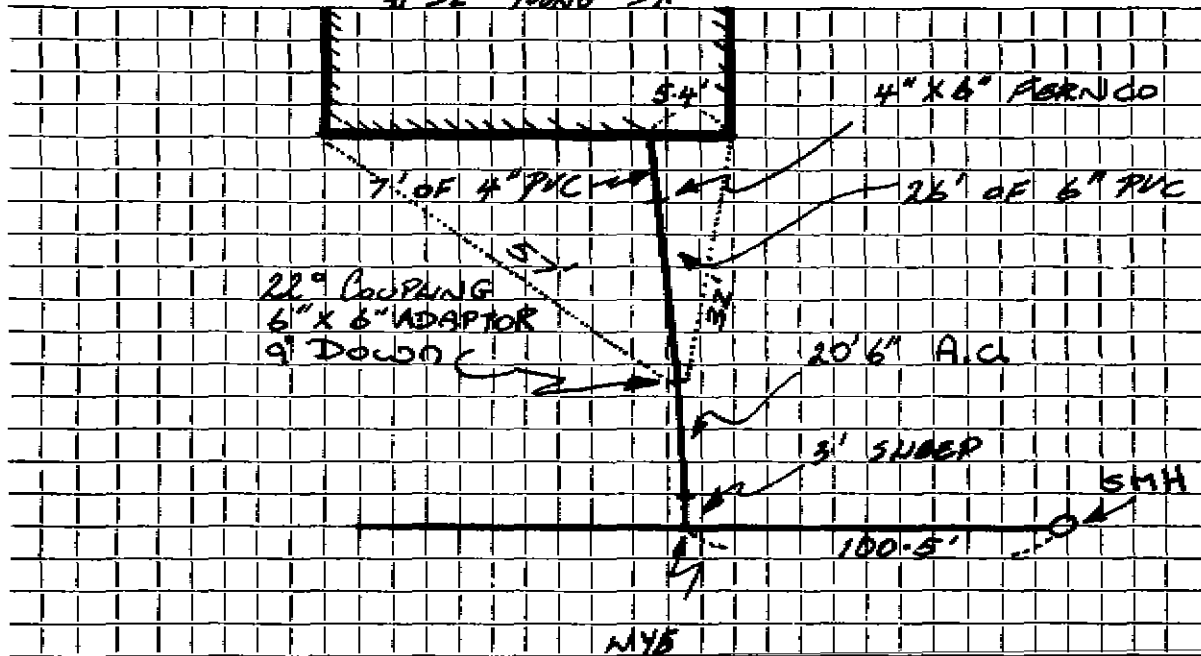

Connection made in ..... Young ..... Street. Work completed .....

Remarks: INSPECTED ..... 10-19-'90 ..... BY P. BARROWS ..... CONTRACTOR ..... B. MCKEE .....