




DATE 10-12-'90

TOWN OF LEXINGTON — BOARD OF PUBLIC WORKS  
SEWER DIVISION

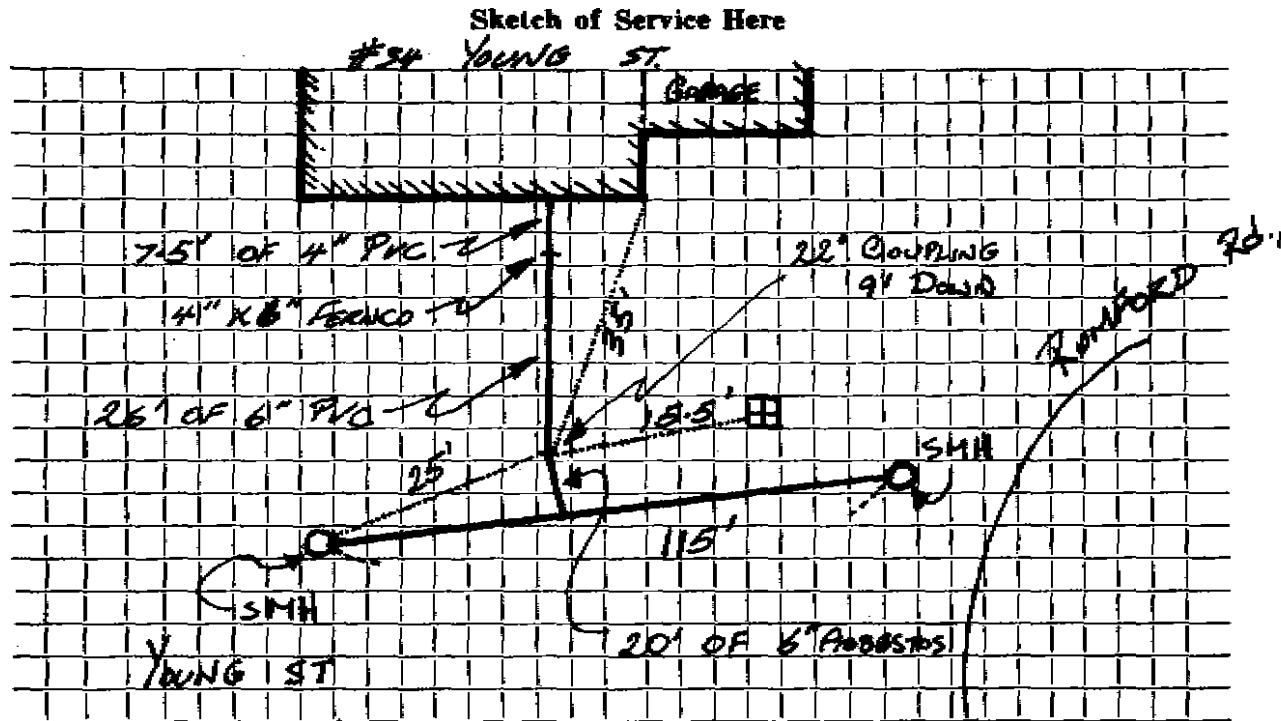

Connection made in YOUNG Street. Work completed .....

Remarks: .....