




DATE 6/23/22

TOWN OF LEXINGTON — BOARD OF PUBLIC WORKS  
SEWER DIVISION

Sketch of Service Here

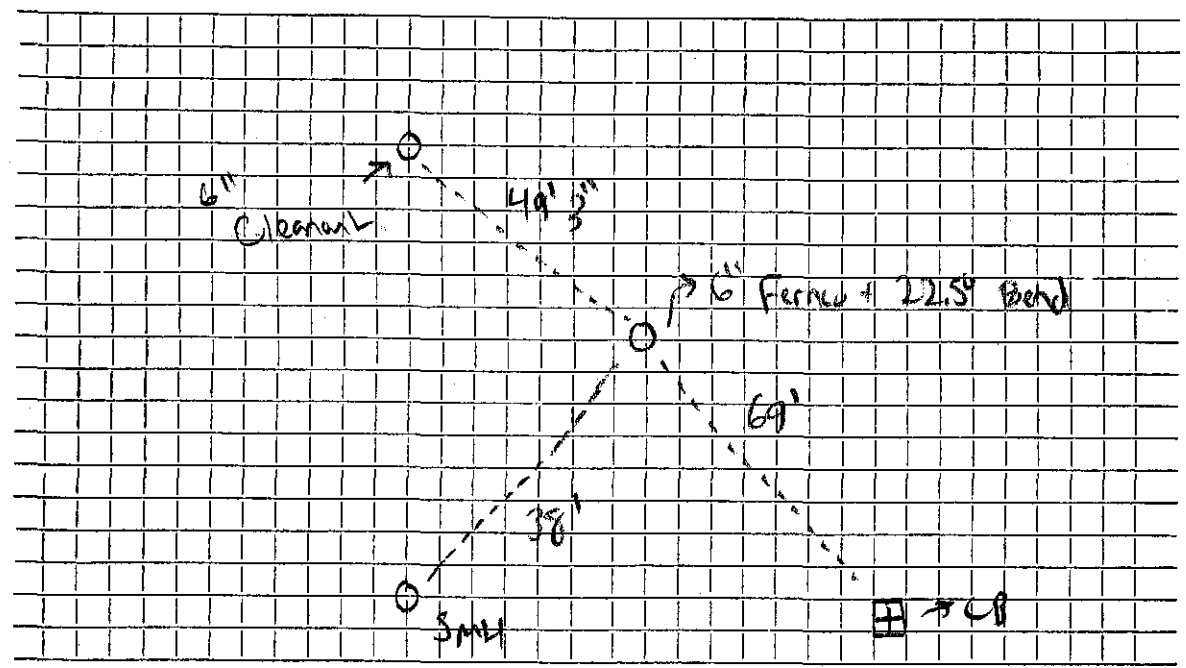

Connection made in ..... Street. Work completed .....

Remarks: ..INSTALLED... By... MCLAUGHLIN.....  
.....  
.....