




DATE

# TOWN OF LEXINGTON — BOARD OF PUBLIC WORKS SEWER DIVISION

Sketch of Service Here

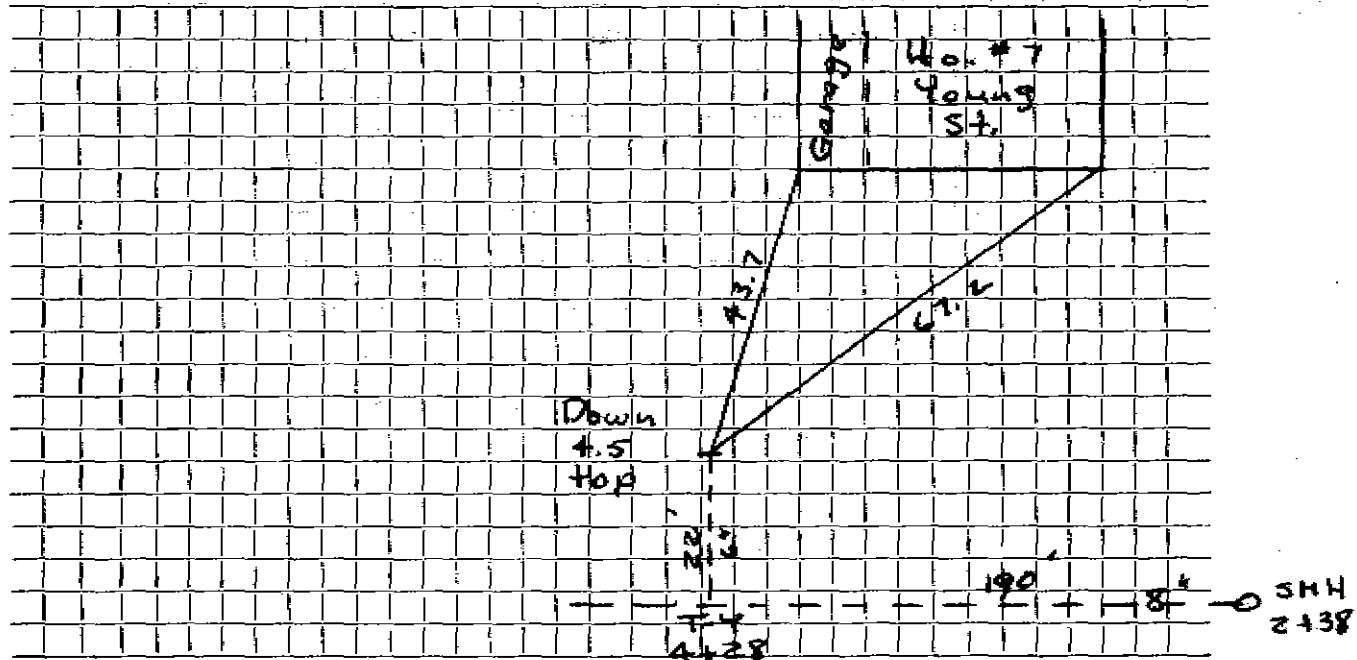

Connection made in Young St. Street. Work completed .....

Remarks: .....  
.....  
.....