




DATE 10/20/17

TOWN OF LEXINGTON — BOARD OF PUBLIC WORKS  
WATER DIVISION

Sketch of Service Here

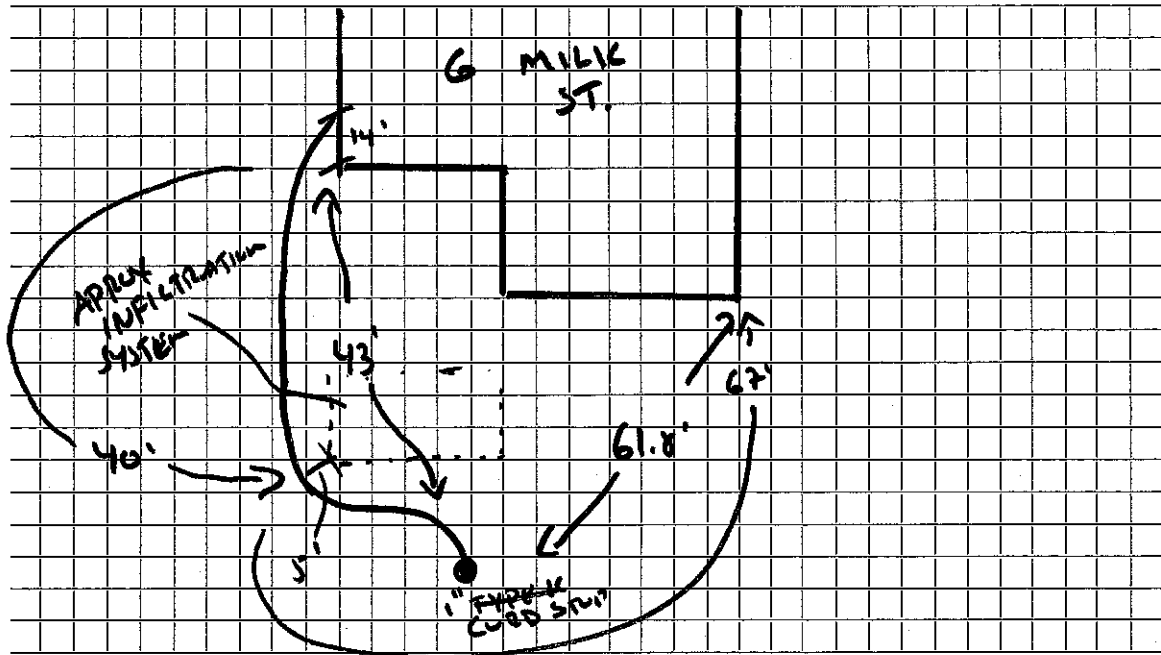

Connection made in ... Milk Street.

Work completed ... PECORA CONSTRUCTION

Remarks: .....