


DATE 1/2018

TOWN OF LEXINGTON — BOARD OF PUBLIC WORKS

WATER DIVISION

Sketch of Service Here

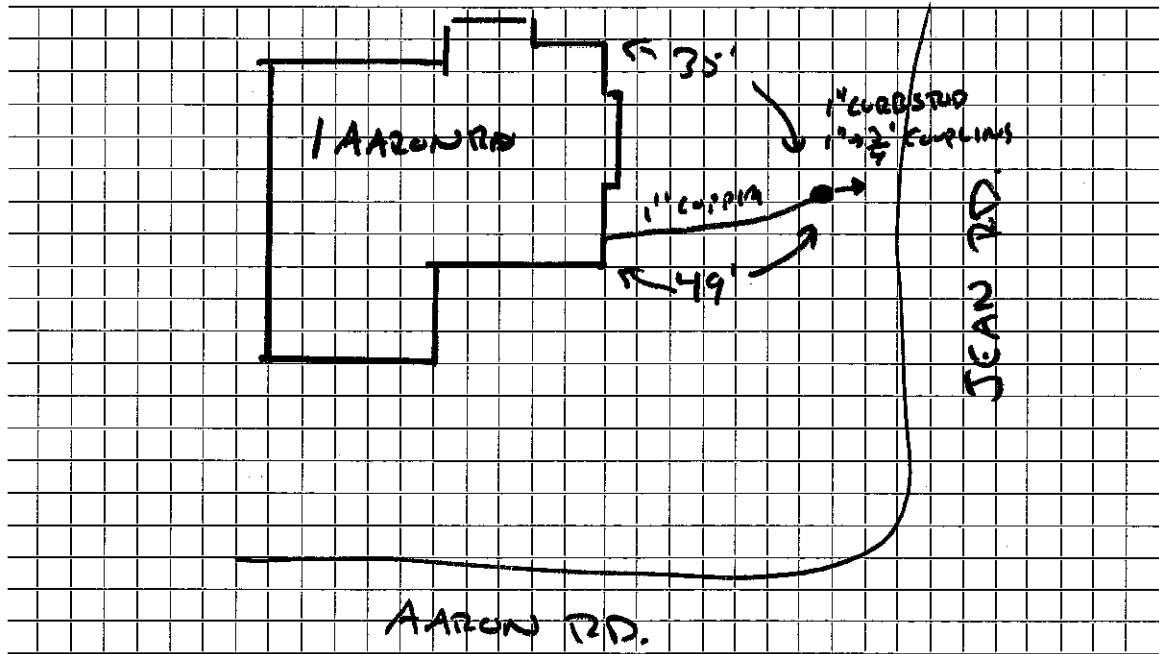

Connection made in JEAN Street. Work completed M. C. LAUREN

Remarks: