

Name Locke, Elinor W.
 Address 3 Abbott Road, Lexington

Service No. 38 /

#3999

Location Same

Kind of Pipe Size Size of Main

~~Repair to Existing~~ - New Service

Location

Date	Material	Amount	Total	Date	Amount
1936					
Aug. 27	19 hrs. labor @ 60¢	11 40			
	41 1/2 " " @ 55¢	22 83	34 23	Sept 14 1936	Cash 17 93
	10% Ovhd. on labor		3 42	5-21-90	3/4 copper outside
	58 1/2" C.L. Pipe @ 24¢	13 92			
	3 1/2" L.L. Coup. @ 22¢	66			
	1 1/2" L.L. Ell. @	45			
	1 Stop & Waste	1 75			
	1 1" Brass Nipple	40			
	Trucking	1 00	18 18		
			55 83		
	Labor				

Hadley Press, Inc., Lexington

Conn. of lat
to Russell
#5583

DATE Sept 14, 1936

TOWN OF LEXINGTON—BOARD OF PUBLIC WORKS WATER DIVISION


The undersigned applies for a supply of water at No. 3 Abbott Road St. and hereby agrees to comply with the rules and regulations as now, or at any future time, established by the Board of Selectmen.

Am't. of Estimate \$ 55.83
Betterm't. Assm't. \$ 144.00
Am't. Paid \$ _____

Owner Elinor W. Locke
Address 3 Abbott Rd
Lexington

Builder _____

Sketch of Service Here

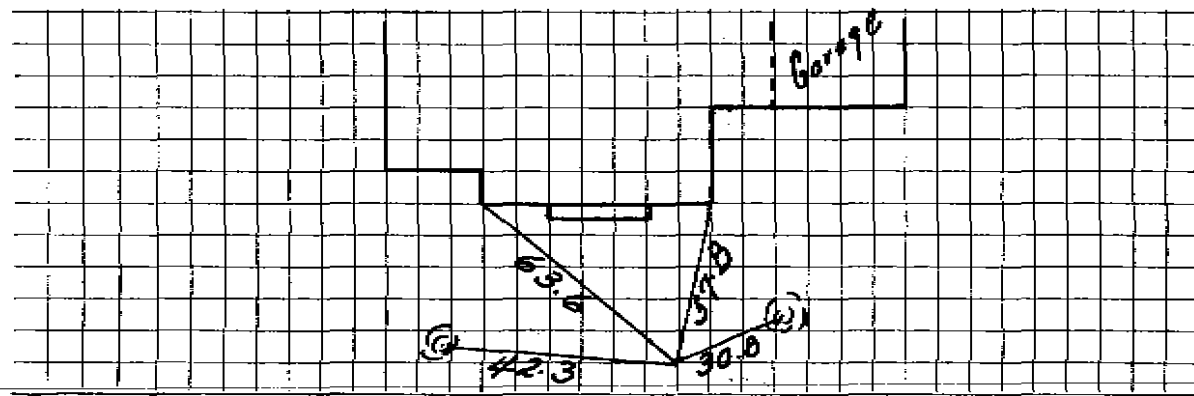

Connection made in _____ Street. Work completed _____ 19

Remarks: checked 5-21-90 3/4 Copper outside