

# WATER SERVICE RECORD

# 5991

Name **State Road Dep.**

Service No. **54**

Address **Albion Road**

Location

**New Service Building Bros. Permit #336 - W.D. #501**

OCT 25 1965


Date	Material	Amount	Total	Debit	Credit	Balance
6-25-65	Labor	59 50			Deposit	100 00
	10% O.H.	5 95	65 45			
22	3/4" copper tubing @ .42		9 24			
1	3/4" Corp.		7 41			
1	3/4" Gurb		8 76			
1	Box & Rod		4 90			
1	Hr. Town Truck		3 00			
1	Hr. Town Shovel		6 50			
			105 26			
7-27-65	38' 3/4" Copper tubing					

*all work done*

TOWN OF LEXINGTON — BOARD OF PUBLIC WORKS

WATER DIVISION

Sketch of Service Here

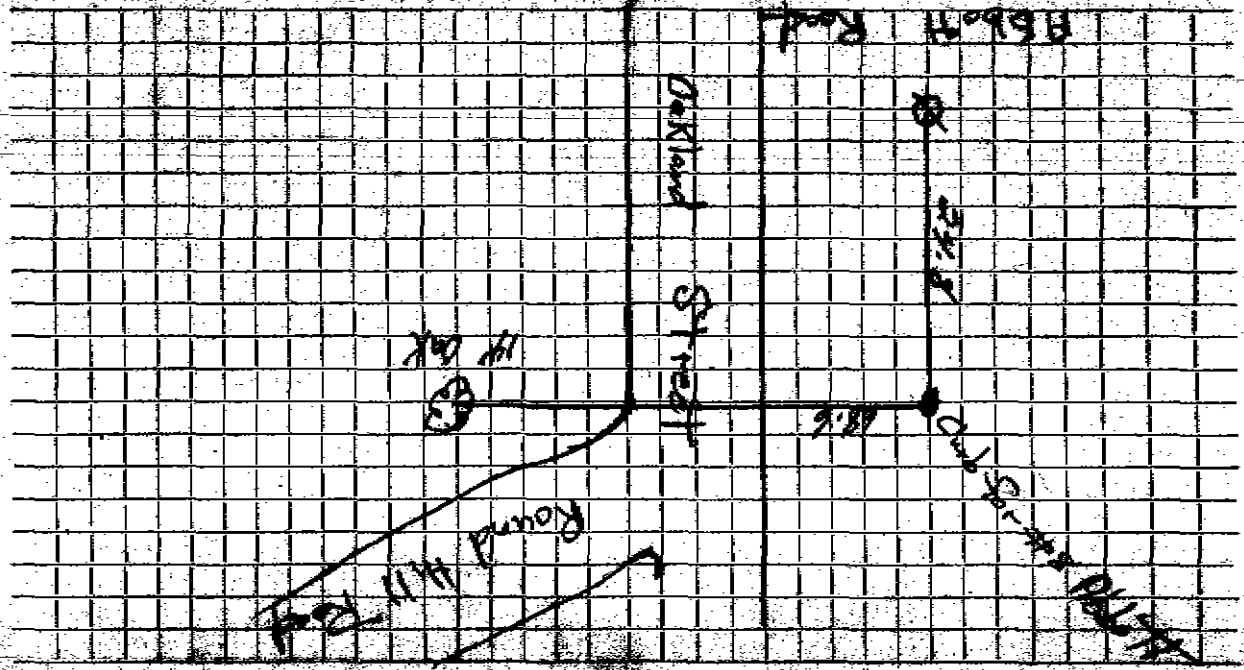

Connection made in

Street

Work completed

Remarks: