




DATE \_\_\_\_\_

# TOWN OF LEXINGTON — BOARD OF PUBLIC WORKS

## WATER DIVISION

Sketch of Service Here

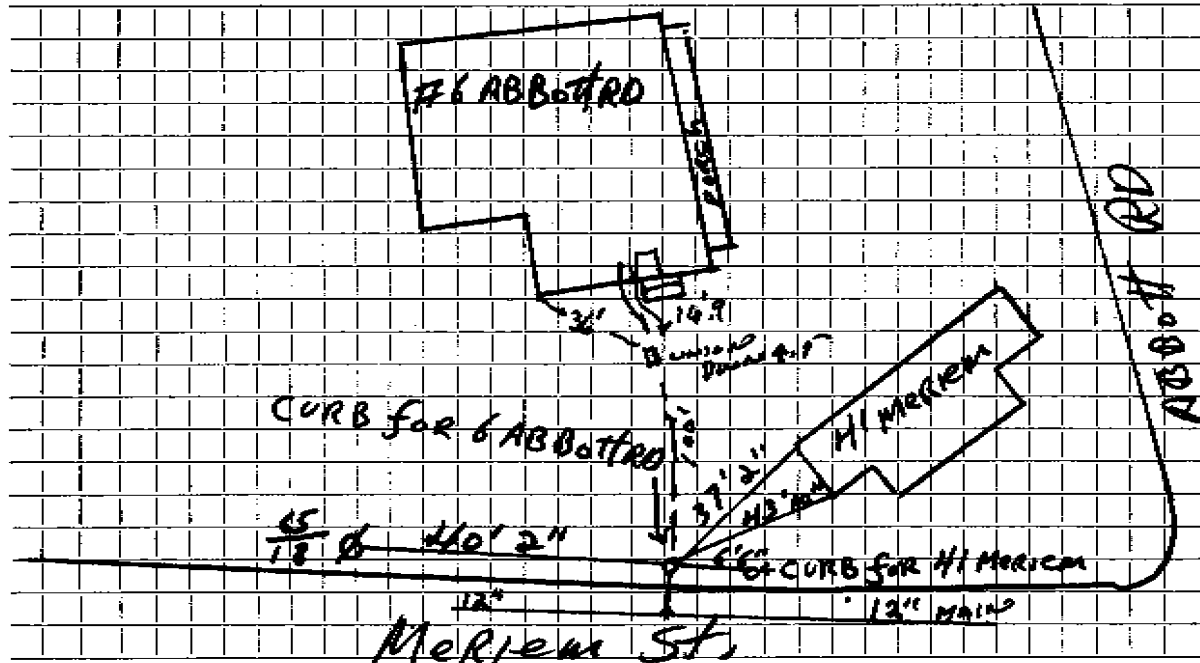

Connection made in MERVIAN ST Street. Work completed .....

Remarks: Lead on the main on the side .....

Insulation on A.T. Fieldstone Foundation .....