

# 3991

WATER SERVICE RECORD

Name Moore Homes Inc.

Service No. 54

Address 8 Abbott Road

Location

~~REPAIR WORK~~ - New Service Deflice Bros. Permit #336 - W.O. #504

OCT 25 1965


Date		Material	Amount	Total	Date	Amount
6-25-65		Labor	59 50		6-16-65	100 00
		10% O.H.	5 95	65 45	Deposit	
	22'	3/4" copper tubing @.42		9 24		
	1	3/4" Corp.		7 41		
	1	3/4" Curb		8 76		
	1	Box & Rod		4 90		
	1	Hr. Town Truck		3 00		
	1	Hr. Town Shovel		6 50		
				105 26		
7-27-65	38'	3/4" Copper tubing				

DATE \_\_\_\_\_

TOWN OF LEXINGTON — BOARD OF PUBLIC WORKS

WATER DIVISION

Sketch of Service Here

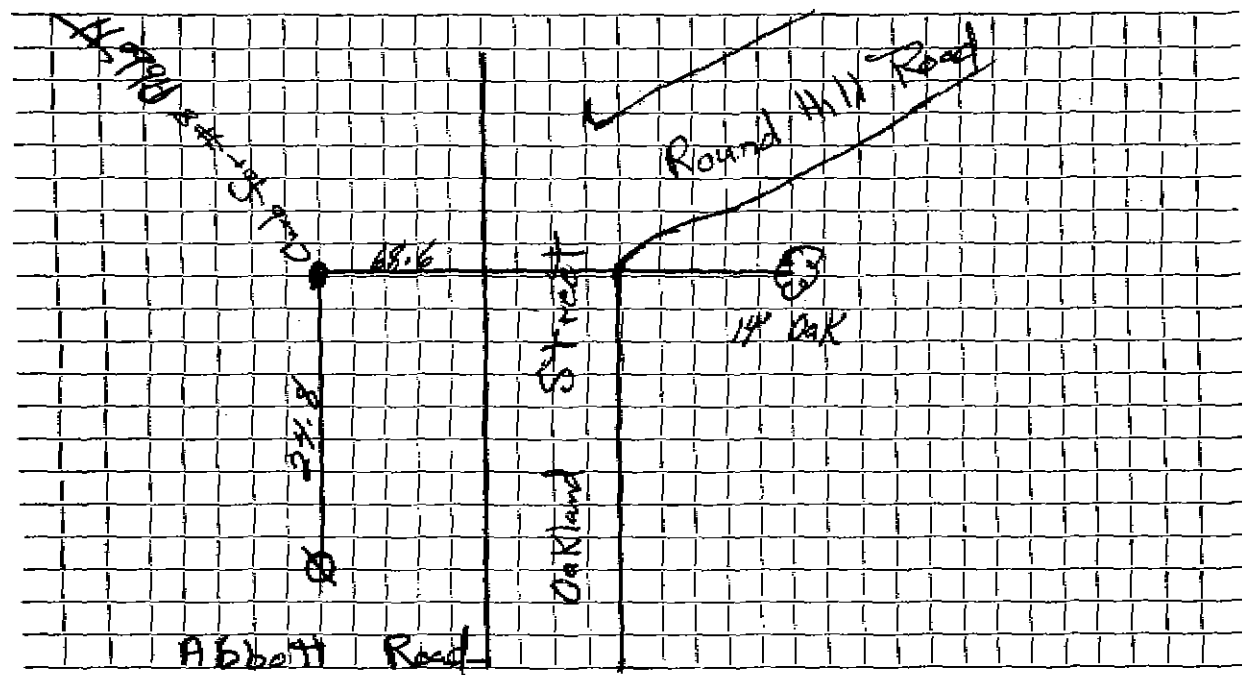

Connection made in ..... Street. Work completed .....

Remarks: .....  
.....  
.....