

#5888

WATER SERVICE RECORD

Name Esco Builders

Service No. 24

Address 2 Abernathy Road

Location

Report Number - New Service WO # 8643

JUN 29 1964


Date	Material	Amount	Total	Date		Amor
1/6/64	Labor	2 42		49.64	Deposit	.50
	1. # L.H.	24	2 66	6/29/64	Paid by 7/25	.35
	100' 3/4" Copper Tubing @ .42		42 00			.53
	1 3/4" x 1/2" I.W.H. Stop & Waste	6 17				
	1 3/4" C3 Part Union	2 31	5/21/64	1 1/2 Straight Tailpiece		5
			53 14		1 1/2 Offset Tailpiece	
						1 0

DATE _____

TOWN OF LEXINGTON — BOARD OF PUBLIC WORKS

WATER DIVISION

Sketch of Service Here

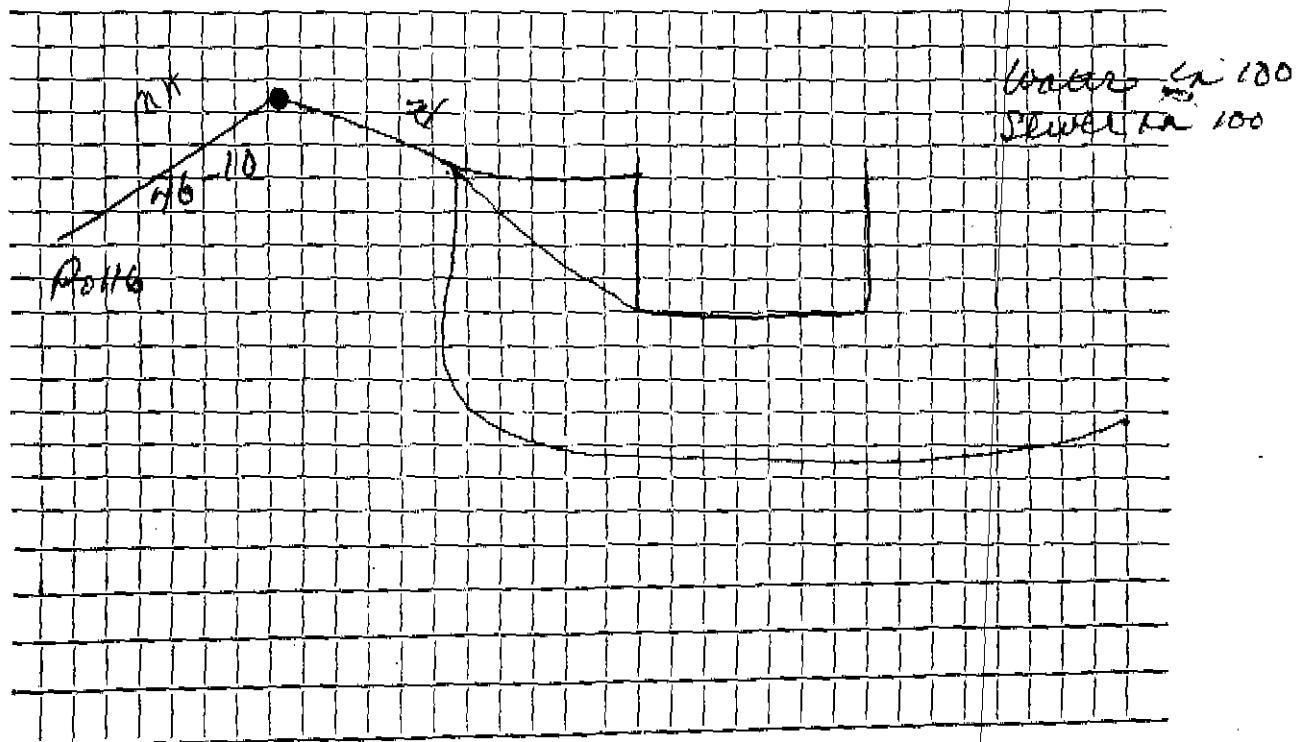

Connection made in Street. Work completed