

WATER SERVICE RECORD

Service No. 134

2717

Name Ecco Builders

Address 4 Abernathy Road

Location

~~Basic Service~~ - New Service W.O. #8292

MAR 23 1964


Date	Material	Amount	Total	Date	Amount
11/12/63	Labor	2 42		11-6-63	50 00
	10% Overhead	24	2 66	3-23-64	15 97
60'	3/4" Copper tubing @ .42		25 20		34 13
1	3/4" Cx 1/2 I.W.H. Stop & Waste		6 17		NON CHARGE
			34 03	11/12/63	1 1/2 Straight tailpiece
					1 1/2 Offset tailpiece
					1 00

DATE _____

TOWN OF LEXINGTON — BOARD OF PUBLIC WORKS

WATER DIVISION

Sketch of Service Here

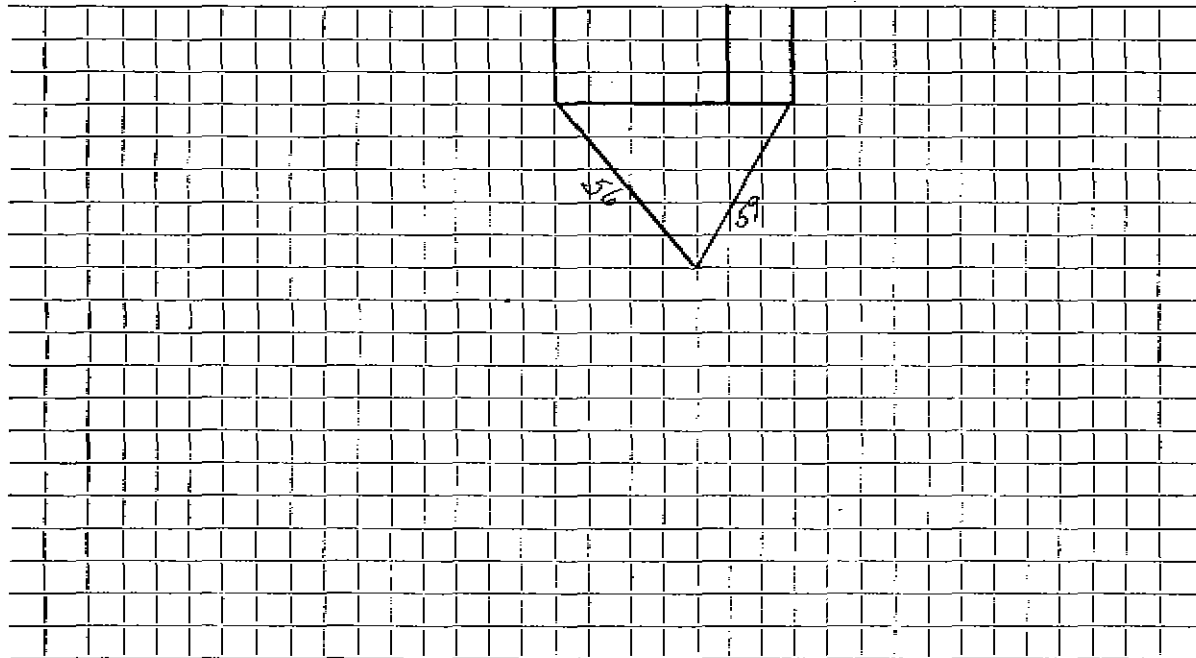

Connection made in Street. Work completed

Remarks:
.....
.....