

## WATER SERVICE RECORD

# 6754

Name Esco Builders Corp.

Service No. 135

Address 6 Abernathy Road

Location

~~Water Service~~ - New Service W.O. #8293

MAR 23 1964


Date	Material	Amount	Total	Date	Amount
11/12/63	Labor	2 42			
	10% Overhead	24	2 66	11-6-63	50 00
	46' 3/4" Copper tubing @ .42		19 32	3-23-64	21 85
1	3/4" Cx 1/2 I.W.H. Stop & Waste		6 17		28 15
			28 15		
				11/12/63	NON CHARGE
					1 1/2 Straight tailpiece
					1 1/2 Offset tailpiece
					50
					50
					1 00

DATE \_\_\_\_\_

# TOWN OF LEXINGTON — BOARD OF PUBLIC WORKS

## WATER DIVISION

Sketch of Service Here

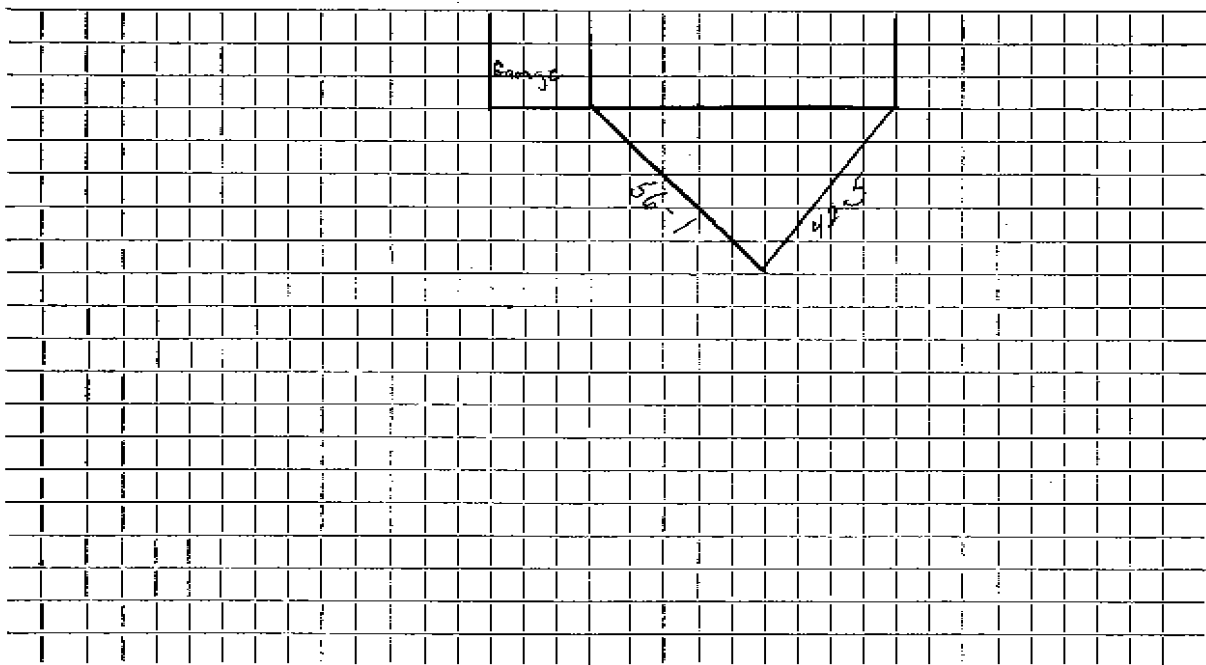

Connection made in ..... Street. Work completed .....

Remarks: .....  
.....  
.....