

WATER SERVICE RECORD

Name **Esco Builders**

117Z
Service No. 64

Address **8 Abernathy Road**

Location **W.O.#9004**

~~XXXXXXXXXX~~ New Service

DEC 28 1964


Date	Material	Amount	Total	Date	Amount
7-8-64	Labor	5 19		1-30-64	Deposit 50 00
	10% O.H.	52	5 71	12-28-64	Retand 8 41
65'	3/4" Copper tubing @.42		27 30		41 59
1	3/4 X 1/2 Comp. Valve		6 17		
1	3/4-3 Part Union		2 41		NON CHARGE
			41 59	1	Box & Rod 4 90
				1	1/2 Offset tailpiece 50
				1	1/2 Straight tailpiece 50
					5 90

DATE _____

TOWN OF LEXINGTON — BOARD OF PUBLIC WORKS

WATER DIVISION

Sketch of Service Here

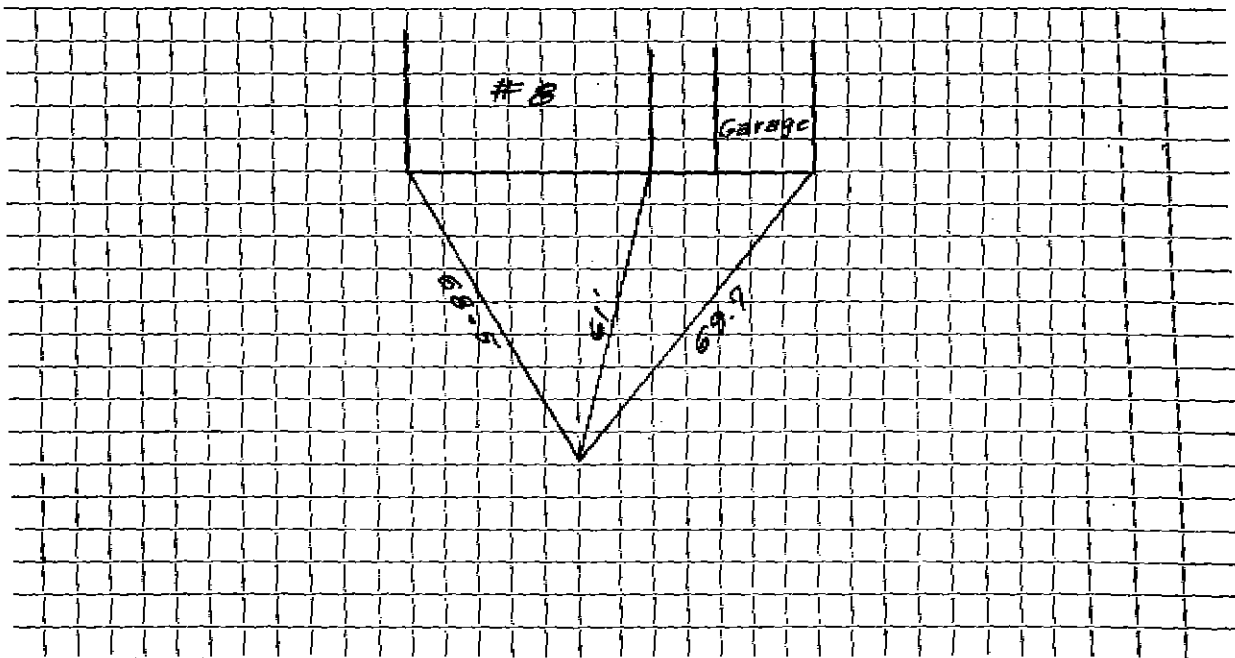

Connection made in Street. Work completed

Remarks:
.....
.....