

WATER SERVICE RECORD

#5919

Name William F. Gedick

Service No. 170

Address 101 Adams Street

Location

~~Repair~~—~~Renewal~~—New Service


Comm. 10-28-57

Date	Material	Amount	Total	Date	Amount
8/23/57	labor	14 36		8-8-57	Deposit \$100 00
	10% overhead	1 44	15 80	10-28-57	Refund \$10 97
	82' 3/4 copper tubing @.375	30 75	30 75		\$89 03
	1 3/4" C x 1/2 IWH stop & waste	4 96	4 96		NON CHARGE
	3 hrs. trucking @.75	2 25	2 25	8-28-57	labor 32 44
	2 hrs. town shovel @6.50	13 00	13 00		25' 3/4" copper tubing.375 9 38
	1 3/4" C union 3 part	2 27	2 27		1 3/4" C corp cock 5 94
	20 x 3 patch	20 00	20 00		1 3/4" C curb cock 4 64
			69 03		1 box & rod 4 62
					1 1/2 straight tail piece 50
					1 1/2 offset tail piece 50
					1 hr town shovel @6.50 6 50
					1 hr trucking 75
					65 27

DATE _____

TOWN OF LEXINGTON — BOARD OF PUBLIC WORKS
WATER DIVISION

Sketch of Service Here

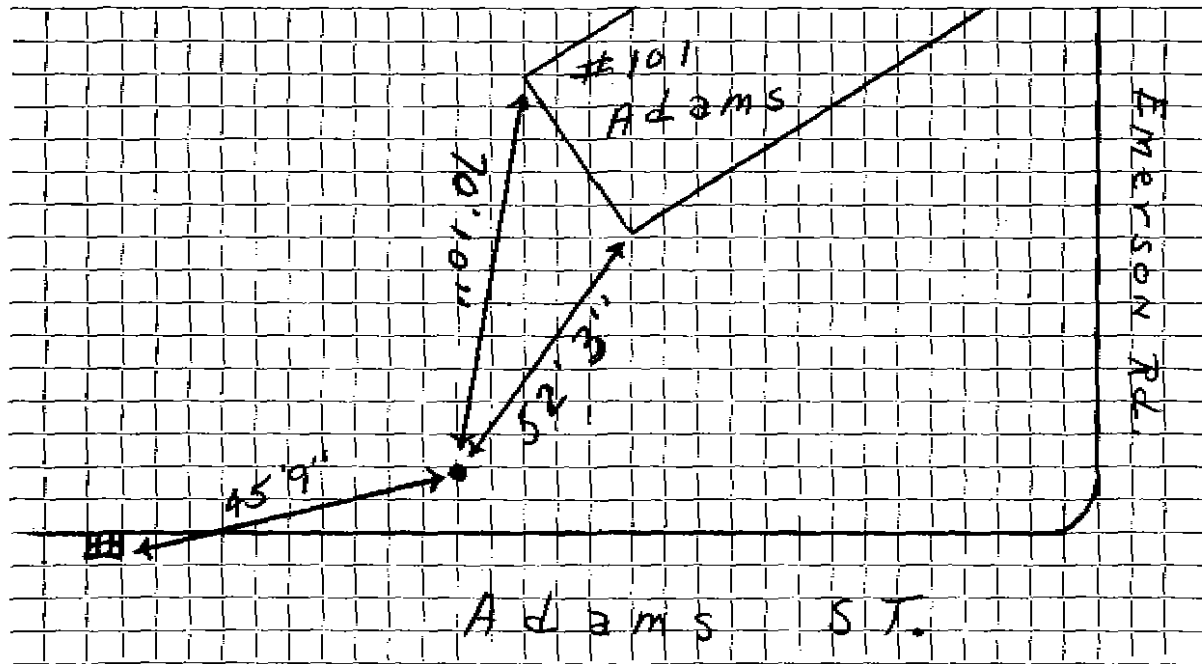

Connection made in Street. Work completed

Remarks:
.....
.....