

WATER SERVICE RECORD

# 114

Name Moore Realty Truct  
 Address (111 Adams Street)  
 Mail: 3 Piehl Road  
 Location

Service No. 185

~~Repair - Renewal~~ - New Service

Comm. 12-1-58

Date	Material	Amount	Total	Date	Amount
9/9/58	Labor	5 84		9-4-58	50 00
	10% Overhead	58	6 42	12-16-58	16 90
	84'-3/4" Copper Tubing @.37		31 08		66 90
	1-3/4" C x 1/2 IWH Stop & Waste	5 84			NON CHARGE
	1-3/4" C 3 Part Union		2 27	9/9/58	
	1 hr. Trucking @.75		75	Labor	30 04
	20 x 3 Patch		20 00	24'-3/4" Copper Tubing @.37	8 88
			66 36	1-3/4" C Corp Cock	4 64
				1-3/4" C Curk Cock	6 03
				1 Box & Rod	5 00
				1-1/2 Straight Tailpiece	50
				1-1/2 Offset Tailpiece	50
				1 Hr. Town Shovel @6.50	6 50
				1 Hr. Trucking @.75	75
					62. 84


Bill sent 12/1/58 16.36

DATE \_\_\_\_\_

**TOWN OF LEXINGTON — BOARD OF PUBLIC WORKS**

**WATER DIVISION**

Sketch of Service Here

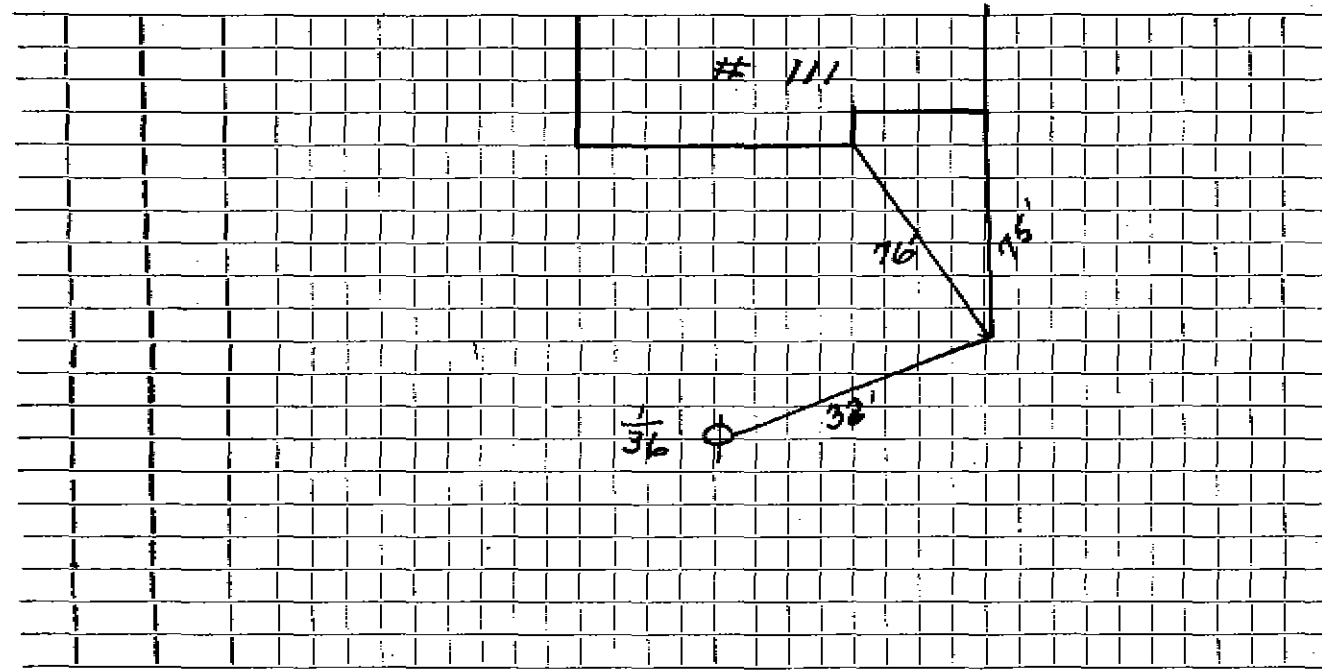

Connection made in . . . . . Street. Work completed . . . . .

Remarks: . . . . .  
. . . . .  
. . . . .