


DATE 10/4/89

TOWN OF LEXINGTON — BOARD OF PUBLIC WORKS
WATER DIVISION

Sketch of Service Here

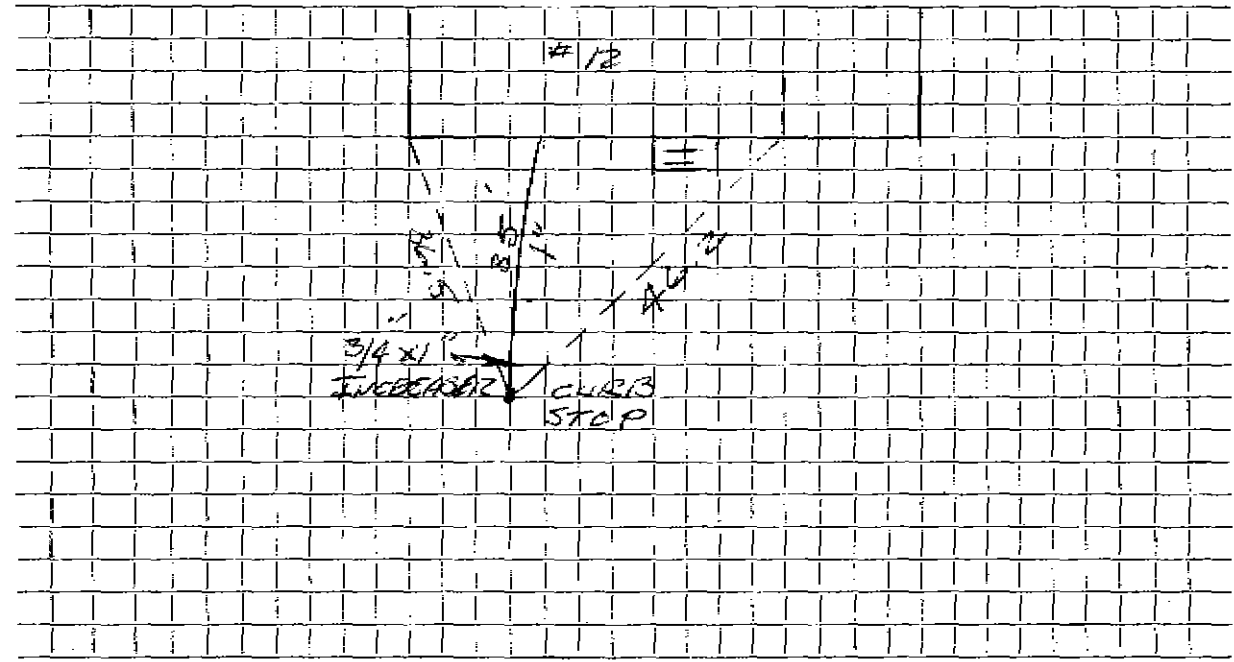

Connection made in ADAMS Street. Work completed 10/4/89

Remarks: 3/4" COPPER IN STREET