


**Water Service Tie Card**  
**TOWN OF LEXINGTON**  
 MASSACHUSETTS

**124 Adams St**

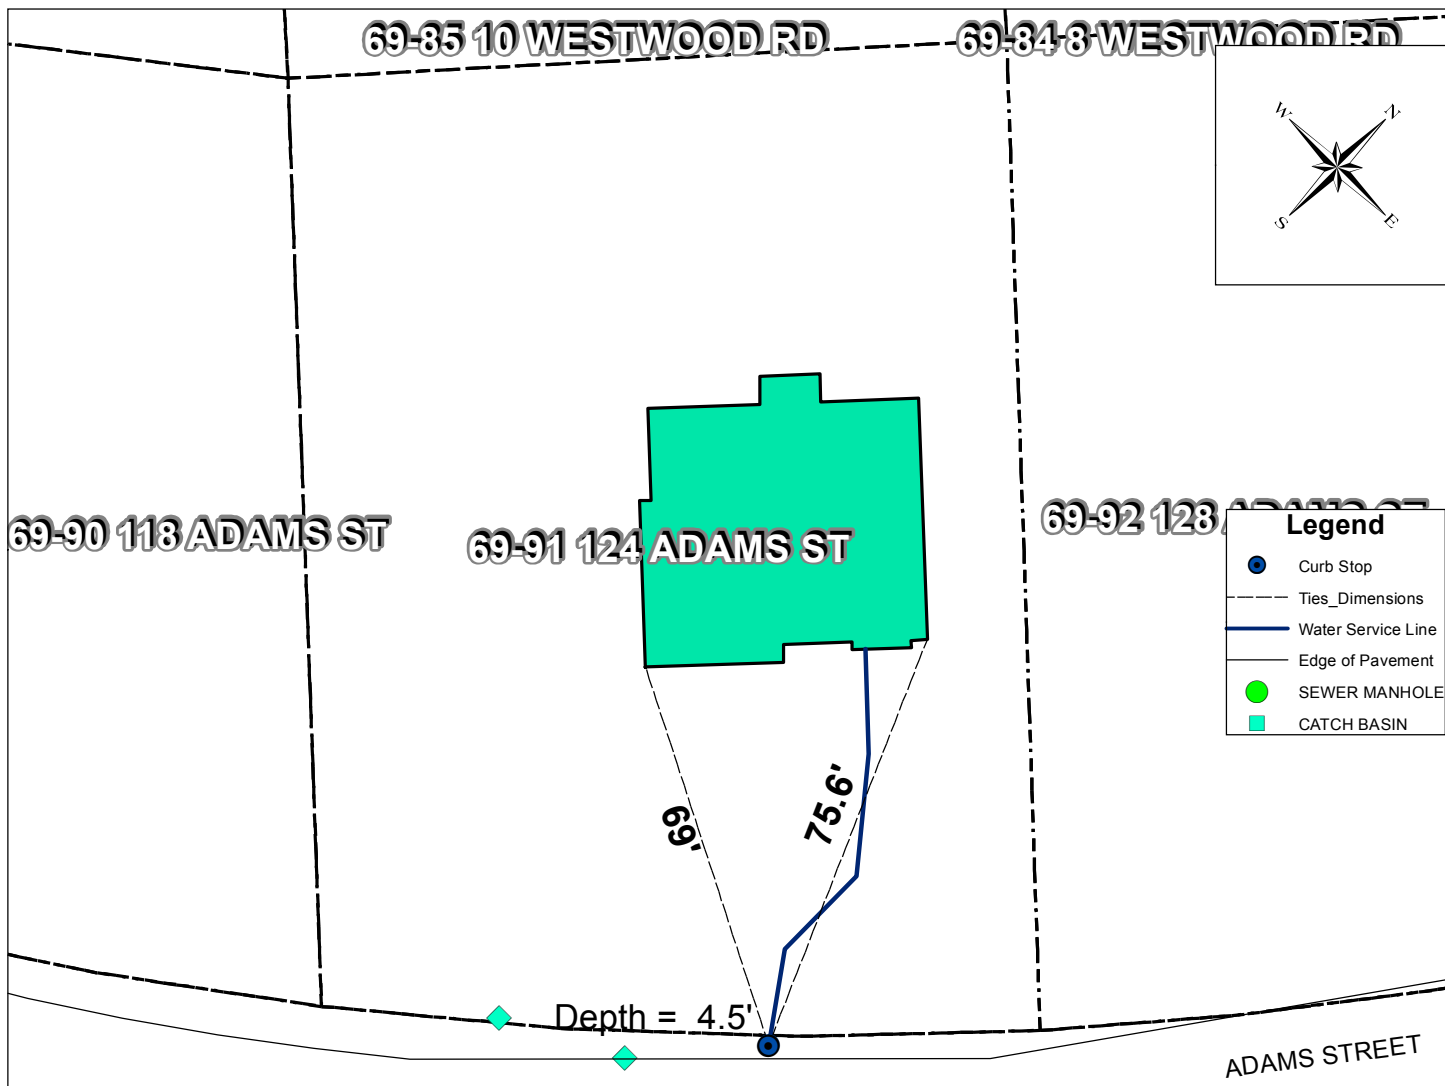

Address	Map and Lot	Permit Number	Contractor Name	Inspector
124 Adams St	69-91	6139	Eycon Construction	msprague
Date	Material	Depth of Cover	Amount	
4/30/2015	3/4" Copper type "k"	4.5 ft	1 ft	
	3/4" to 1" fitting	4.5 ft	1	
	1" Copper type "k"	4.5 ft	1 ft	
	1" Curb Valve and Buffalo Box	4.5 ft	1	
	1" Copper type "k"	4 ft	68 ft	
Type of work completed				

New 1" water service to house from curb stop. New house on lot old house removed.