

WATER SERVICE RECORD

Name Universal Development Corp

Service No. 224

Address 128 Adams Street

Location \_\_\_\_\_

~~Repair & Renewal~~ - New Service

*Com. 8-31-53*


Date	Material	Amount	Total	Date	Amount
8/3/53	Labor	1 75		8-3-53 Deposited	7 00
	10% overhead	18	1 93	8-3-53 Refunded	2 32
	1 -3/4"C x 1/2 I.W.H. stop & waste		4 00		<u>NON CHARGE</u>
	1 hr. trucking		75	8/3/53 Labor	8 46
			6 68	9# 3/4" copper tubing @ .3629	3 27
	FRENCH DUG BY OWNER:			1 -3/4"C. corp-cock	4 33
	PIPE SUPPLIED & LAID BY OWNER			1 - 3/4"C x 3/4"C. curb-cock	4 67
				1 box and rod	3 90
				1 -1/2" straight tail pc.	50
				1 -1/2" offset tail pc.	50
				1 hr. trucking	75
					<u>26 38</u>

DATE \_\_\_\_\_

TOWN OF LEXINGTON — BOARD OF PUBLIC WORKS

WATER DIVISION

Sketch of Service Here  
128 Adams St

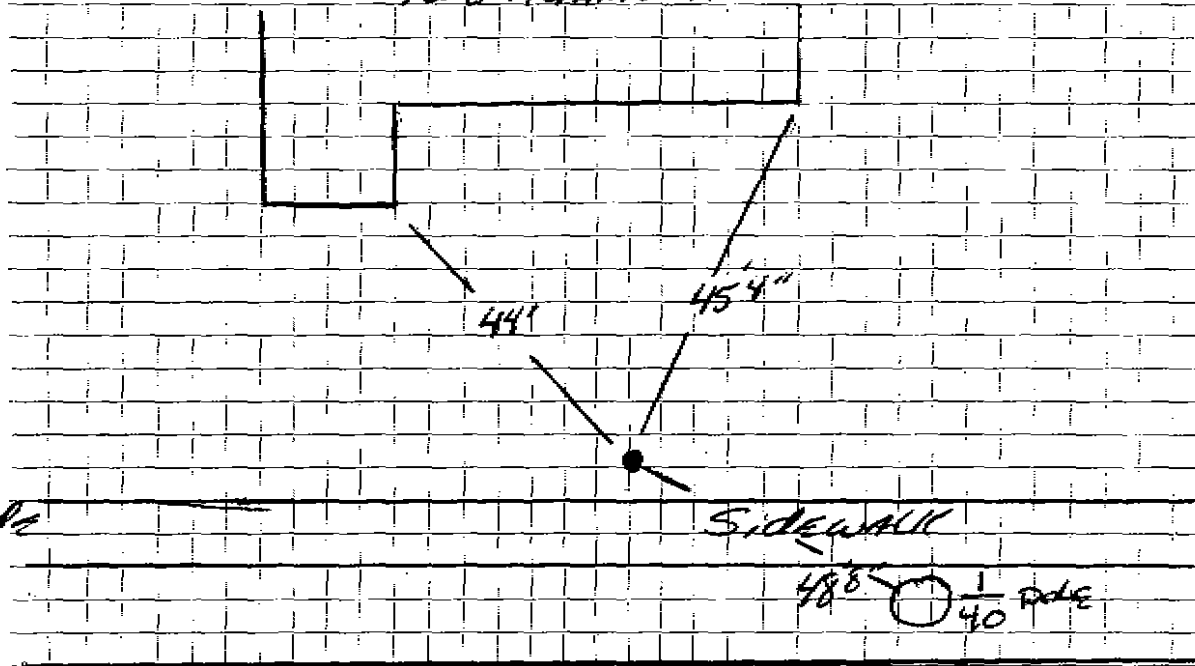

Connection made in ..... Street. Work completed .....

Remarks: .....  
.....  
.....