


DATE _____

TOWN OF LEXINGTON — BOARD OF PUBLIC WORKS

WATER DIVISION

Sketch of Service Here

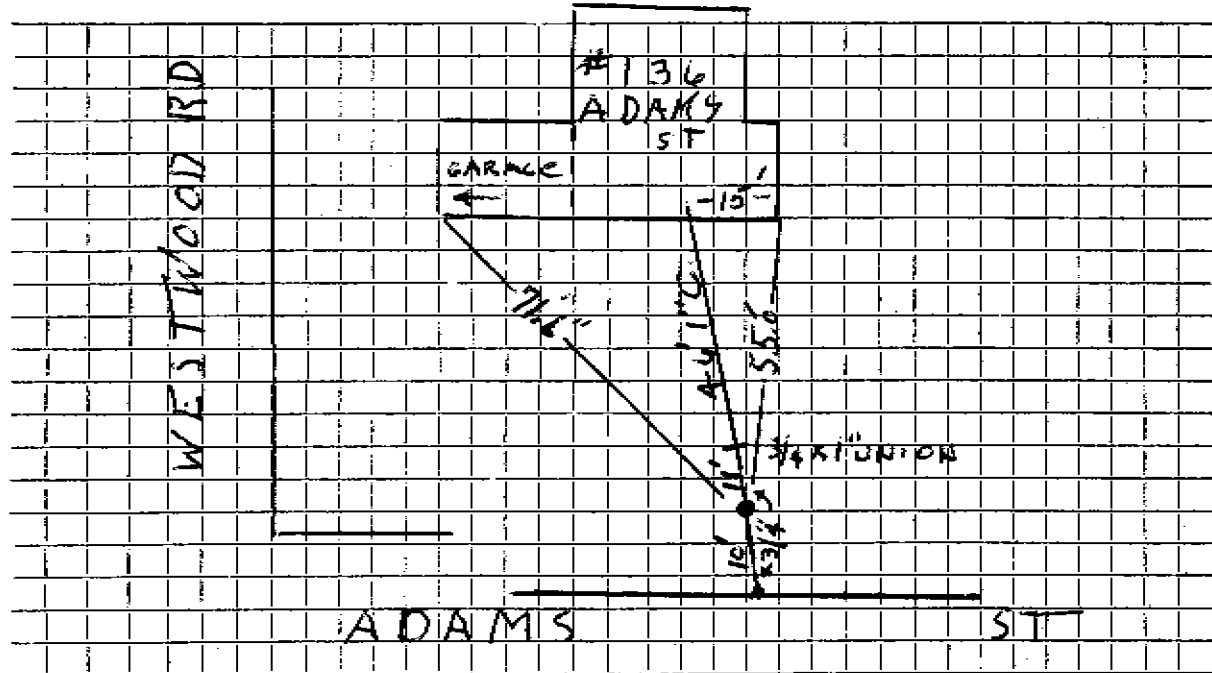

Connection made in ADAMS ST Street. Work completed 5/10/04

Remarks: Elec. under sidewalk, MAY change Address To Westwood