


Water Service Tie Card
TOWN OF LEXINGTON
 MASSACHUSETTS

140 Adams St

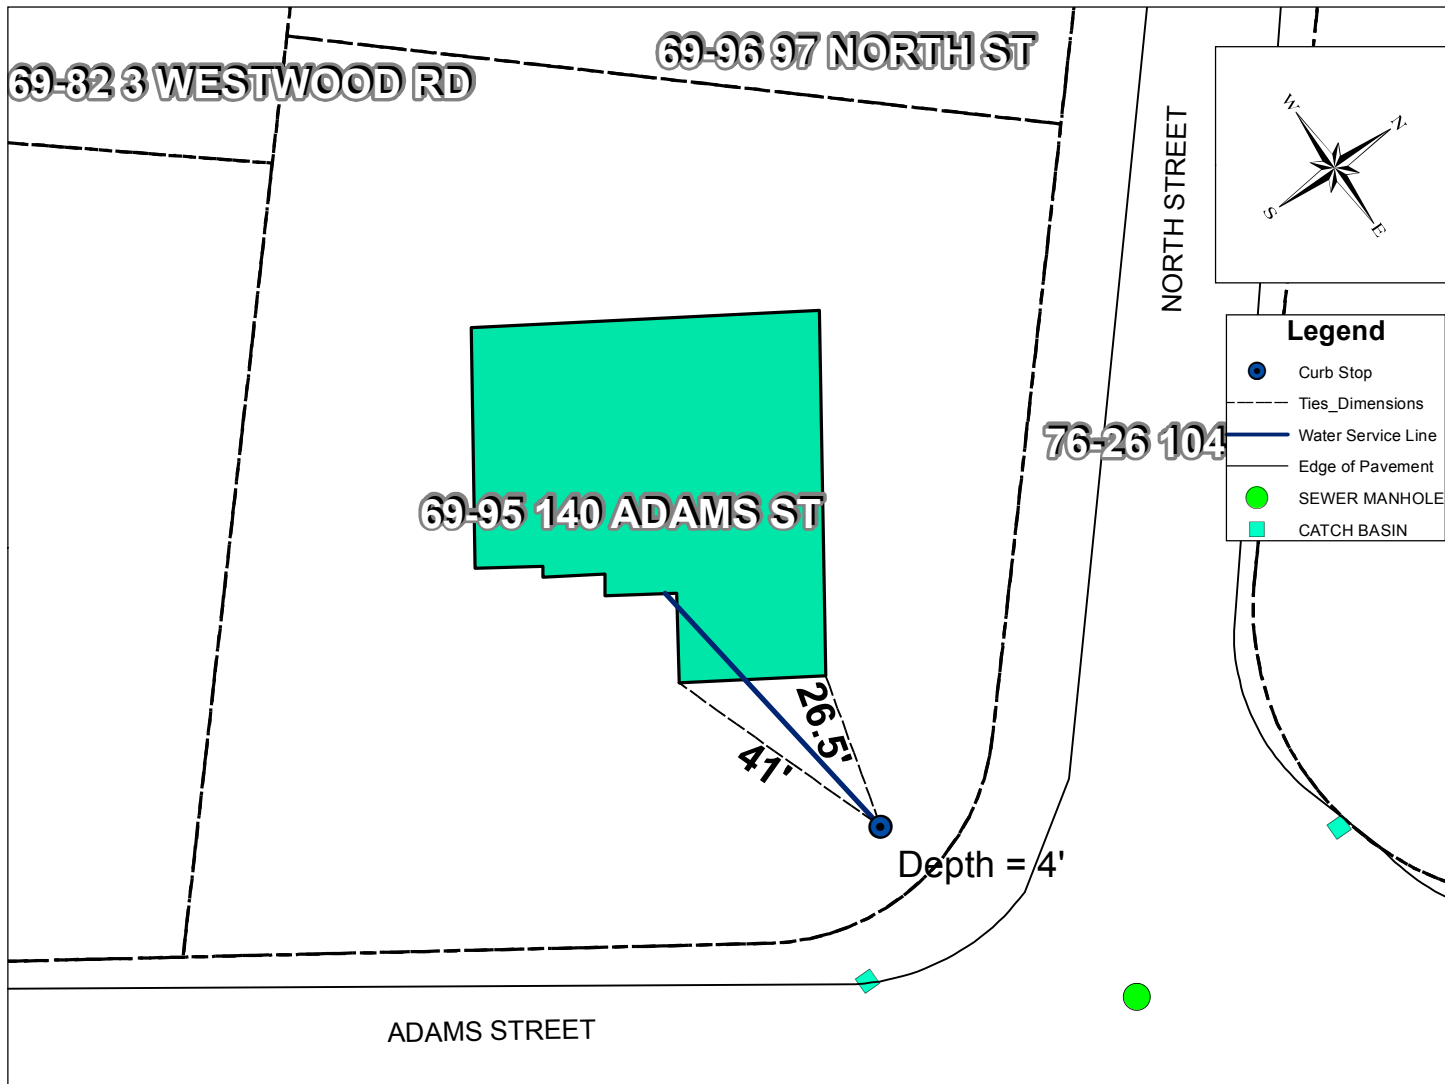

Address	Map and Lot	Permit Number	Contractor Name	Inspector
140 Adams St	69-95	6339	McLaughlin, James M. Inc.	msprague
Date	Material	Depth of Cover	Amount	
8/17/2015	1" Curb Valve and Buffalo Box	4 ft	1	
	1" Copper type "k"	4 ft	50 ft to HSE	
Type of work completed				
New 1" water service to house from curb stop. New house on lot old house removed.				