

Name Harvey C. Wheeler

Service No. <sup>45</sup> 23

Address ~~251~~ Clarendon St., Boston, Mass.

Location 143 Adams Street

Kind of Pipe

Size

Size of Main

Repair—Renewal—New Service

Location

| Date<br>1940 | Material                    | Amount | Total  | Date            | Amount |
|--------------|-----------------------------|--------|--------|-----------------|--------|
| Sept. 9      | 84 hrs. @ 55¢               | 46 20  |        | Aug. 27, 1940   | 300 00 |
| Com 9/30/40  | 108 " @ 60¢                 | 64 80  |        | October 7, 1940 | 70 79  |
|              | 1 " @ 65¢                   | 65     |        |                 |        |
|              | 25 " @ 70¢                  | 17 50  | 129 15 |                 | 229 21 |
|              | 10% Overhead                |        | 12 92  |                 |        |
|              | 306' 1" Copper tubing @ 21¢ | 64 26  |        |                 |        |
|              | 1 1" C x 3/4" I. S. & W.    | 2 25   |        |                 |        |
|              | 4 1" C. Unions @ 1.00       | 4 00   |        |                 |        |
|              | 5 hrs. trucking @ 75¢       | 3 75   |        |                 |        |
|              | Trench repairs              |        | 12 83  |                 |        |
|              |                             |        | 229 21 |                 |        |
|              | Labor                       |        |        |                 |        |

Hadley Press, Inc., Lexington

DATE August 26, 1940  
8/26/40

TOWN OF LEXINGTON—BOARD OF PUBLIC WORKS  
**WATER DIVISION**

The undersigned applies for a supply of water at No. 143 Adams Street St. and hereby agrees to comply with the rules and regulations as now, or at any future time, established by the Board of Selectmen.

Am't. of Estimate \$ 300.00 (Town digs)  
180.00 (Owner digs)  
Am't. Paid \$ 300.00


Owner

Address

Harvey C Wheeler  
131 Clarendon St  
Boston Mass

Builder \_\_\_\_\_

Sketch of Service Here

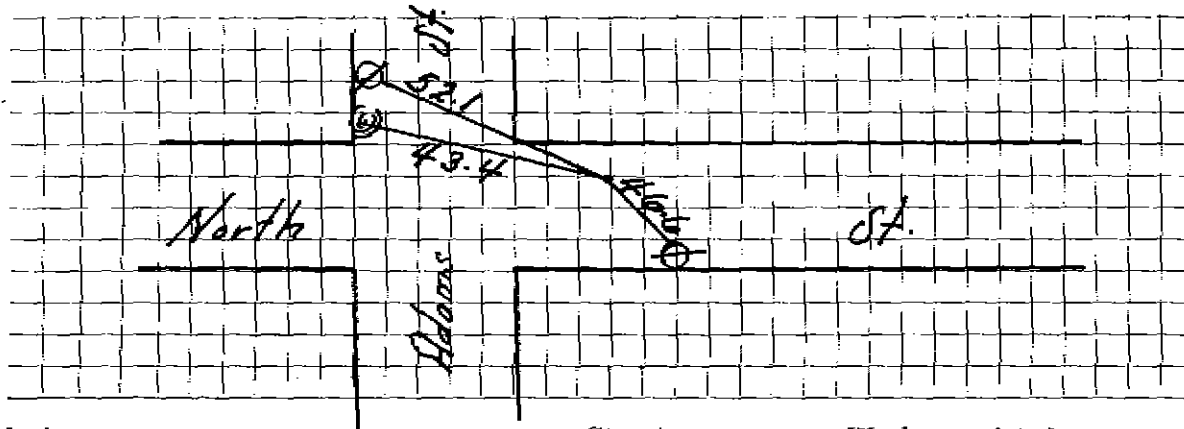

Connection made in \_\_\_\_\_ Street. Work completed \_\_\_\_\_ 19

Remarks: