


TOWN OF LEXINGTON - BOARD OF PUBLIC WORKS
WATER DIVISION

Date: _____

SKETCH OF SERVICE HERE

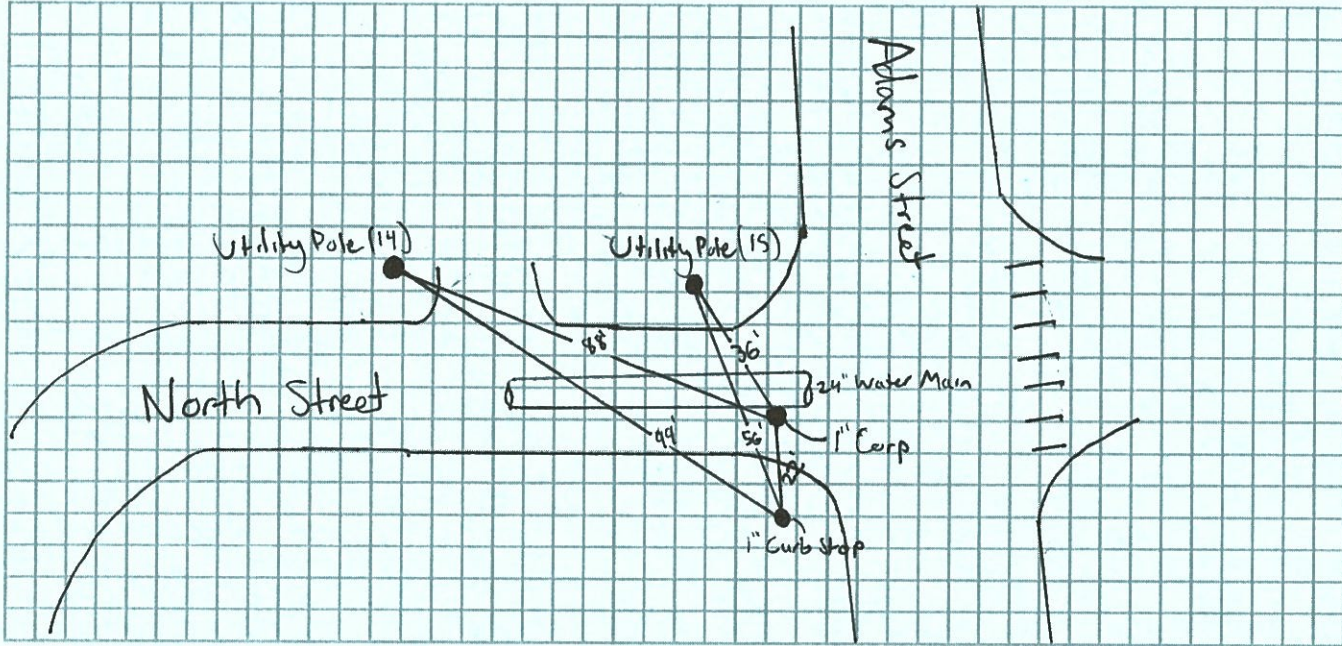

Connection made in: North Street Street. Work completed: _____

Remarks: _____

