



Town of Burlington Engineering Division

25 Center Street
Burlington, MA 01803
Phone (781) 270-1640

Checked By:

SJH

Date:


1/5/2021

Location:

#150 Adams Street

Water Service Tie Card - Installed 10/22/2020

(N.T.S.)

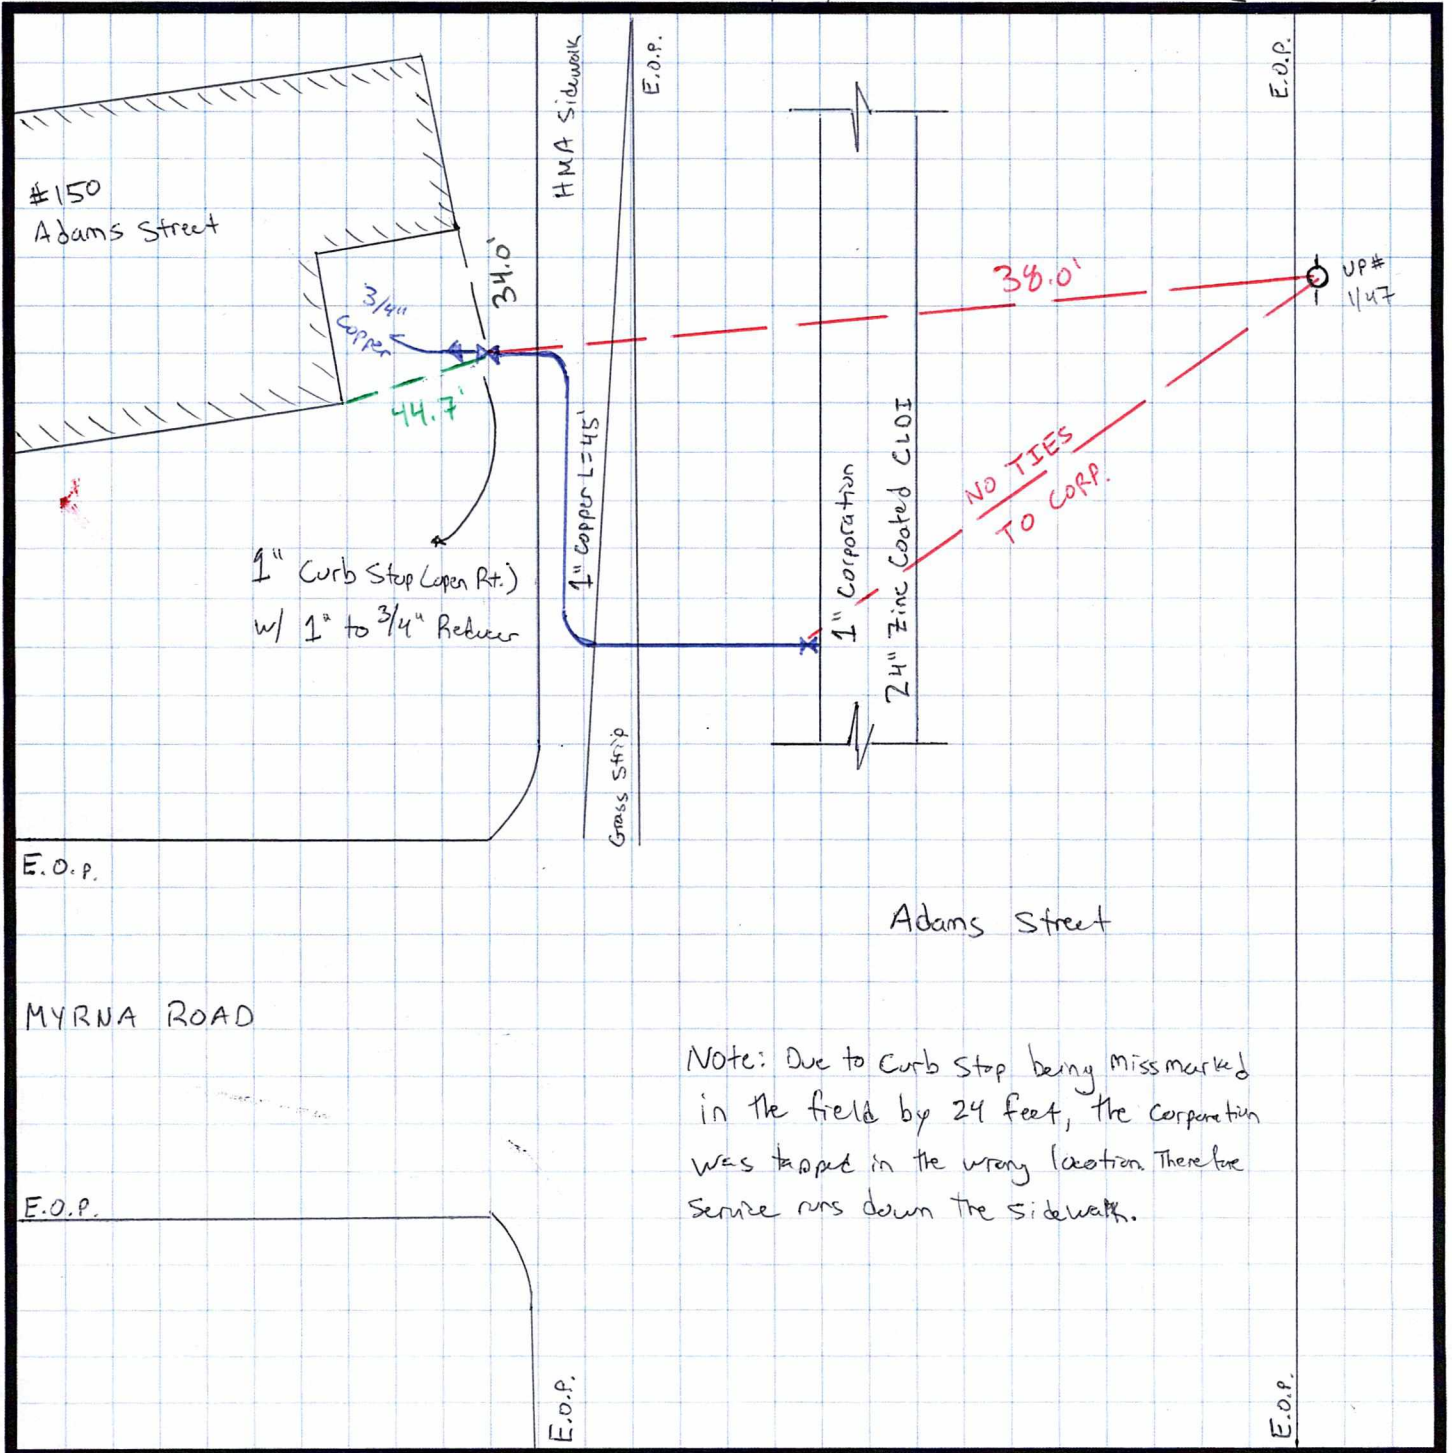

Note: Due to Curb Stop being missmarked in the field by 24 feet, the Corporation was tapped in the wrong location. Therefore service runs down the sidewalk.