



# Town of Burlington Engineering Division

25 Center Street  
Burlington, MA 01803  
Phone (781) 270-1640

Checked By:

SJH

Date:


1/5/2021

Location:

#154 Adams Street

Water Service Tie Card - Installed 10/22/2020

(N.T.S.)

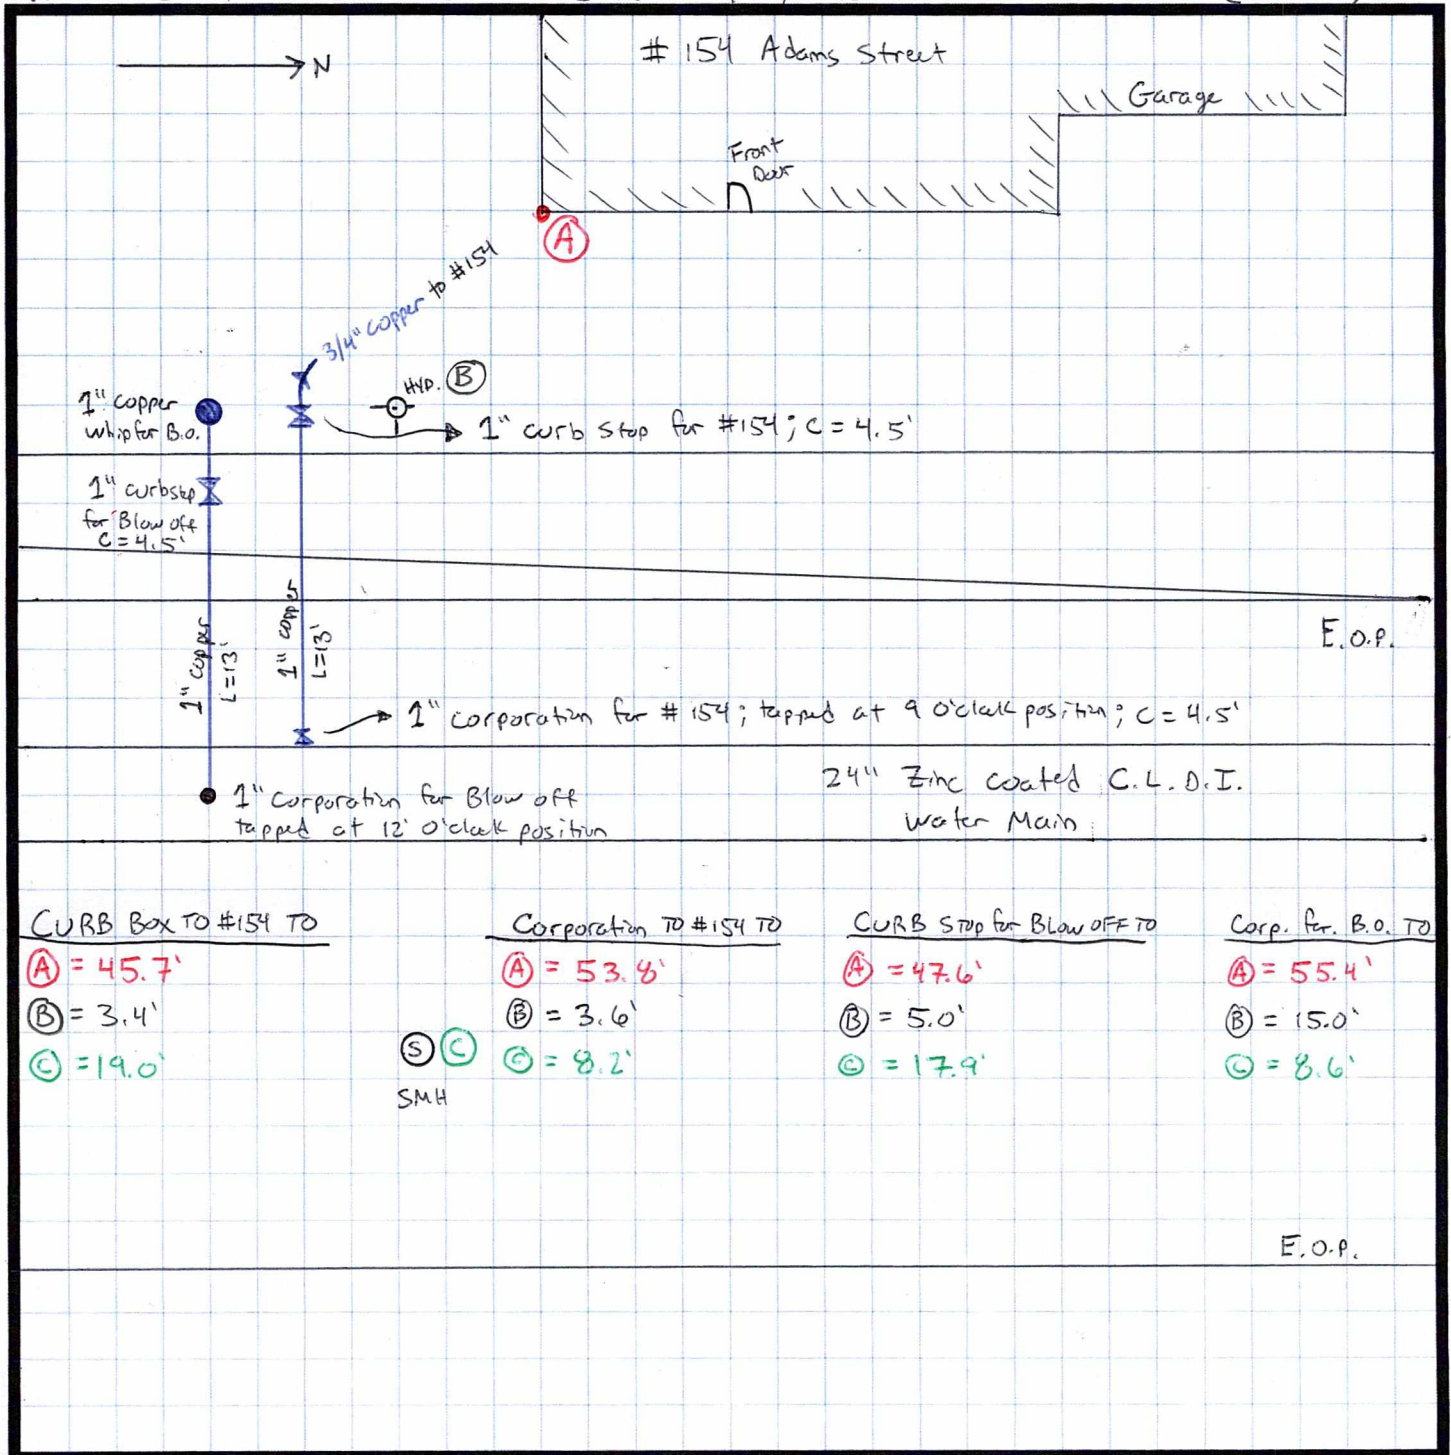

CURB Box TO #154 TO

(A) = 45.7'  
(B) = 3.4'  
(C) = 19.0'

Corporation TO #154 TO

(A) = 53.8'  
(B) = 3.6'  
(C) = 8.2'  
(S) (C)  
SMH

CURB STOP for Blow OFF TO

(A) = 47.6'  
(B) = 5.0'  
(C) = 17.9'

Corp. for B.O. TO

(A) = 55.4'  
(B) = 15.0'  
(C) = 8.6'

E.O.P.