

Name G. A. Simonds
 Address 16 Adams Street
 Lexington, Mass.

Service No.

292
 #2520

Location 16 Adams Street

Kind of Pipe

Size

Size of Main

~~Repair~~—Renewal—~~New Service~~

Location

Date	Material	Amount	Total	Date	Material	Amount
Nov. 17, '48	Labor	29 77	29 77	Nov. 17, '48	Labor	19 50
	10 ⁰⁰ Overhead		2 98		8' - 3/4" Copper tubing @.255	2 04
	78' - 3/4" Copper Tubing @.255	19 89	22 87		1 - 5/8" Copper Adapter	1 50
	1 - 3/4" C x 1/2" I.W.H.S&W	3 15	26 02		1 - 3/4" C x 3/4" Curb-cock	3 00
	1 - 3/4" C x 3/4" C Union	1 32	27 34		1 - Box & Rod	3 55
	Trucking 1 hr. @.75	0 75	28 09		1 - 1/2" Straight Tail Piece	30
			57 86		Trucking 1 hr. @.75	75
					Patching 4 x 3	4 00
						34 64
	Labor					

Reported
Reimbursed
 Non-Charge

DATE _____

TOWN OF LEXINGTON - BOARD OF PUBLIC WORKS

WATER DIVISION

The undersigned applies for a supply of water at No..... St. and hereby agrees to comply with the rules and regulations as now, or at any future time, established by the Board of Selectmen.

Am't of Estimate \$.....

Owner


Am't Paid \$.....

Address

Builder

.....

Sketch of Service Here

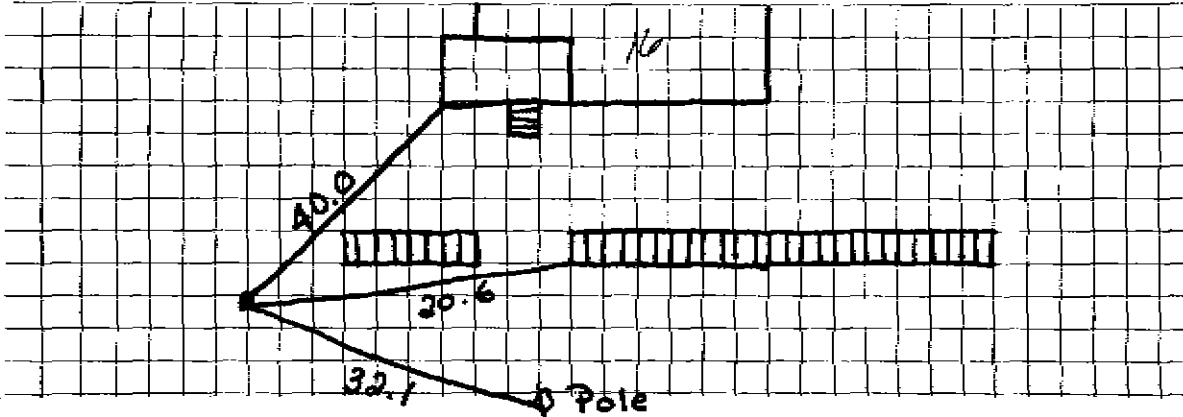

Connection made in Street.

Work completed19

Remarks: