

WATER SERVICE RECORD

Name William Hunt

Service No. 276

Address 17 Adams Street

#7527

Location

~~Repair~~ Renewal - ~~NEW SERVICE~~

am. 11-21-55


Date	Material	Amount	Total	Date	Amount
9/9/55	Labor	13 80		8-22-55	Deposited 50 00
	10% overhead	1 38	15 18	12-20-55	Paid (4 06)
	39' - 1" copper tubing @ .4584	17 88	17 88		NON CHARGE 54 06
	1 - 1" C x 3/4" I.W.H. stop & waste	4 50	4 50	9-8-55	Labor 37 97
	2 hrs. Littlefield shovel @ 7.50	15 00	15 00		27' - 1" copper tubing @ .4584 12 38
	2 hrs. trucking @ 75¢	1 50	1 50		1 - 1" C x 1" C. curb-cock 6 80
			54 06		1 - 1" C. corp-cock 5 61
					1 box and rod 3 90
					1 - 3/4" straight tail pc. 50
					1 - 3/4" offset tail pc. 50
					22 x 3 patching 22 00
					1 hr. trucking 75
					5 hrs. Littlefield shovel @ 7.50 37 50
					127 91

Bill Hunt

TOWN OF LEXINGTON — BOARD OF PUBLIC WORKS

WATER DIVISION

Sketch of Service Here

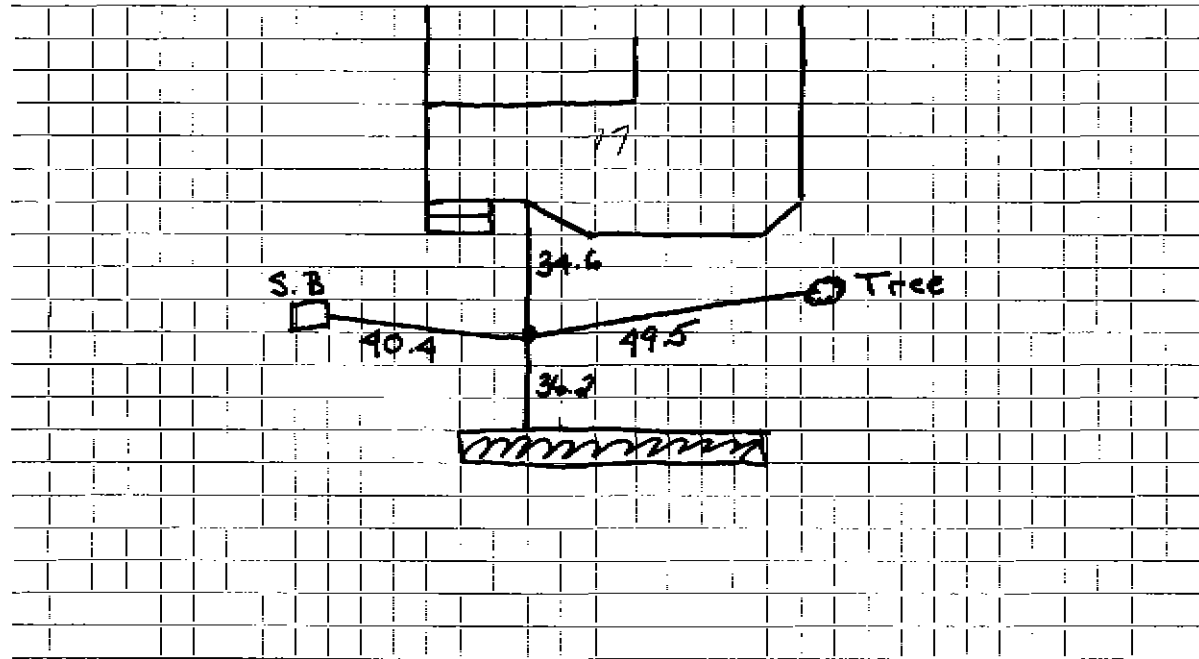

Connection made in Street. Work completed

Remarks:

.....

.....