

Name Paul L. Bauguss
 Address 18 Adams Street, Lexington,

Service No. ~~38~~ 9
 # 5585

Location

Kind of Pipe

Size

Size of Main

~~Repair~~ ~~Renewal~~ New Service

Location

Date 1940	Material	Amount	Total	Date	Amount
July 30,	27 hrs. @ 55¢	14 85		October 2, 1940 Paid	
<i>com 9/30/40</i>	55 " @ 60¢	33 00			80 00
	9 " @ 70¢	<u>6 30</u>	54 15		
	10% Overhead		5 42		
	92' 3/4" Copper tubing @ 18¢		16 56		
	2 3/4" C. Unions (3-part) @ 90¢		1 80		
	1 3/4" C x 1/8" I.S. & W.		2 25		
	2 hrs. trucking @ 75¢		<u>1 50</u>		
			<u>\$81 68</u>		
	Say \$80.00.				
	Labor				

Hadley Press, Inc., Lexington

DATE _____

TOWN OF LEXINGTON—BOARD OF PUBLIC WORKS

WATER DIVISION

The undersigned applies for a supply of water at No. _____ St. and hereby agrees to comply with the rules and regulations as now, or at any future time, established by the Board of Selectmen.

Am't. of Estimate \$ _____

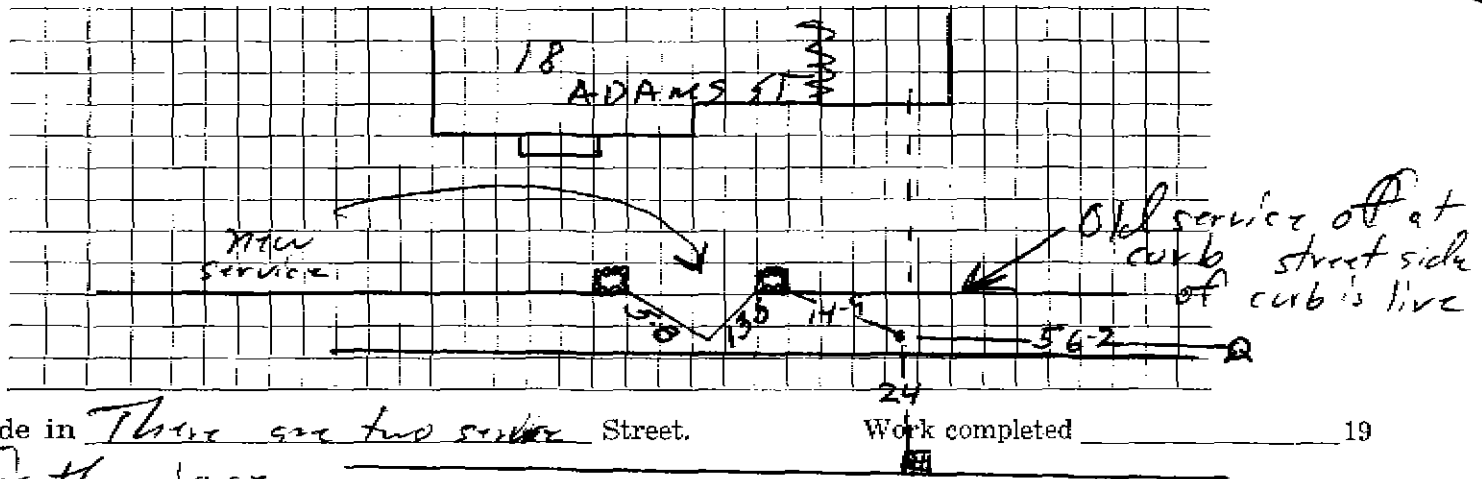
Owner _____

Am't. Paid \$ _____

Address _____

Builder _____

Sketch of Service Here

Connection made in Three see two service Street.

Work completed _____

19 _____

Remarks: for this houseold service may be iron or lead