






DATE JULY 2, 1997

\*55' OF 1" COPPER FROM HOUSE TO UNION PULLED THROUGH OLD SERVICE.

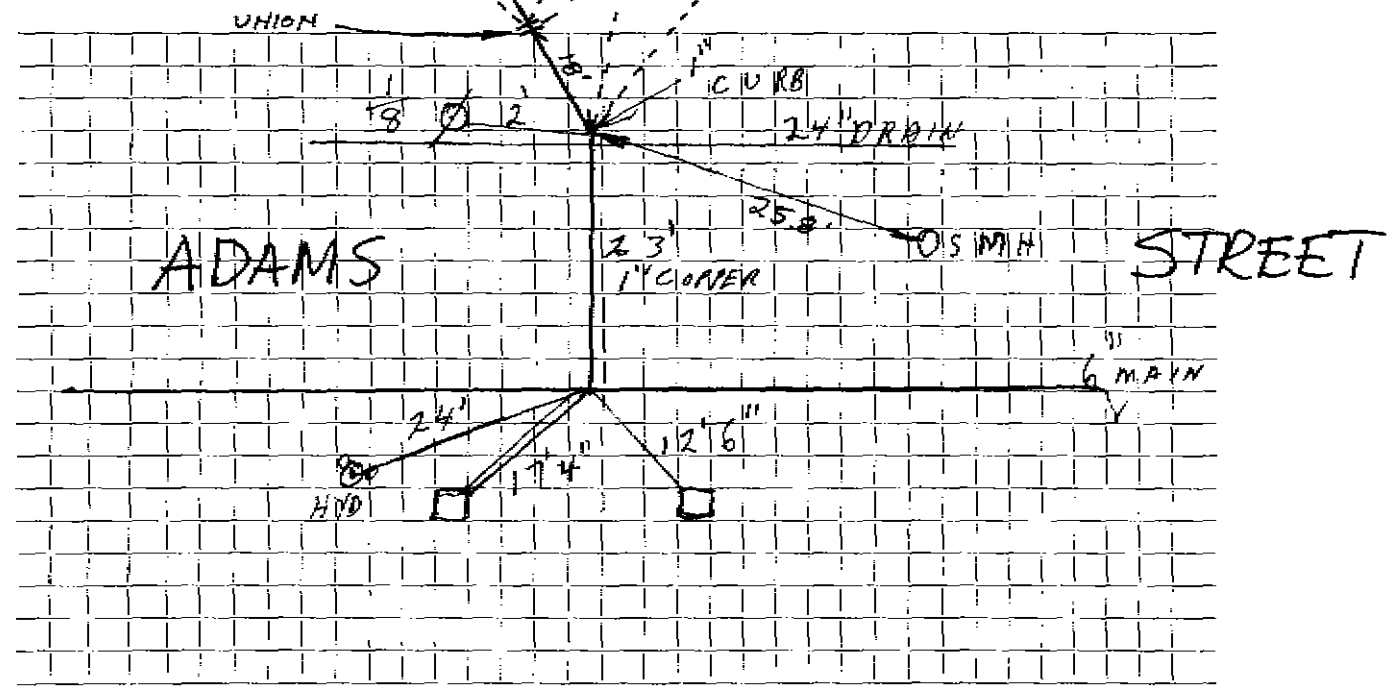

Connection made in ..... Street. Work completed .....

Remarks: .....