

WATER SERVICE RECORD

303

Name Henry Littlejohn

Service No. 44

Address 24 Adams Street

Location Lexington, Mass.

~~Repair-Renewal-New Service~~


Cor. 8-6-51

Date	Material	Amount	Total	Date	Amount
5-8-51	Labor	1 49	1 49	<i>Warrant</i>	<i>33 21</i>
	10% Overhead		15		<i>22 10</i>
	50' - 3/4" Copper Tubing @.326	19 56			<i>11 11</i>
	1 - 3/4" C x 3/8" I.W.B. S&W	4 00	5-8-51	Labor	1 49
	1 - 3/4" C x 3/4" Union (3pts)	1 72		10' - 3/4" Copper Tubing @.326	3 26
	Trucking 1 hr. @.75	75		3 - 3/4" C Corp-cock	4 33
			27 67	1 - 3/4" C x 3/4" Curb-cock	4 67
				1 - Box & Rod	4 68
				1 - 1/2" Straight Tail Piece	50
				1 - 1/2" Offset Tail Piece	50
				Trucking 1 hr. @.75	75
					20 18

DATE _____

TOWN OF LEXINGTON — BOARD OF PUBLIC WORKS
WATER DIVISION

Sketch of Service Here

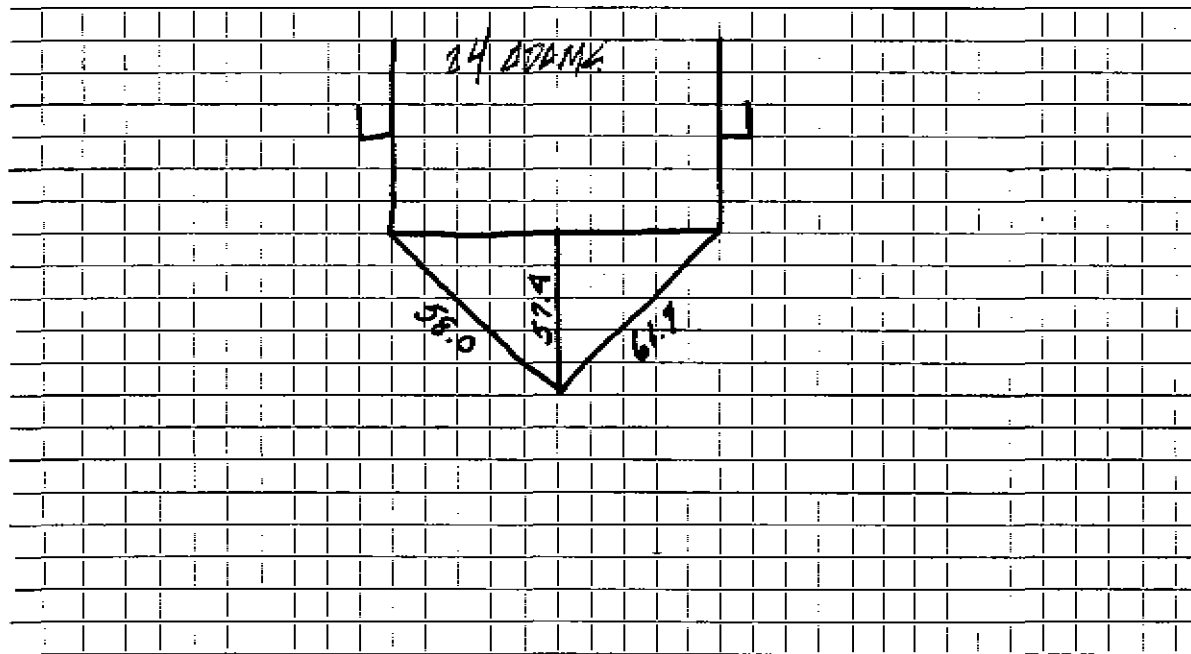

Connection made in Street. Work completed

Remarks:
.....
.....