

Name *N. B. Bidwell*

Service No. *13*
#1544

Address *25 Adams St.*

Location *25 Adams St.*

Kind of Pipe

Size

Size of Main

Repair—Renewal—New Service

Location

Date	Material	Amount	Total	Date	Location	Amount
	<i>Inside 1" Iron</i>			<i>Checked 11-8-90</i>	<i>outside 3/4 Copper</i>	
	Labor					

DATE _____

TOWN OF LEXINGTON—BOARD OF PUBLIC WORKS

WATER DIVISION

The undersigned applies for a supply of water at No. _____ St. and hereby agrees to comply with the rules and regulations as now, or at any future time, established by the Board of Selectmen.

Am't. of Estimate \$ _____


Owner N. B. Bidwell

Am't. Paid \$ _____

Address 15 Adams St. #25

Builder _____

Sketch of Service Here

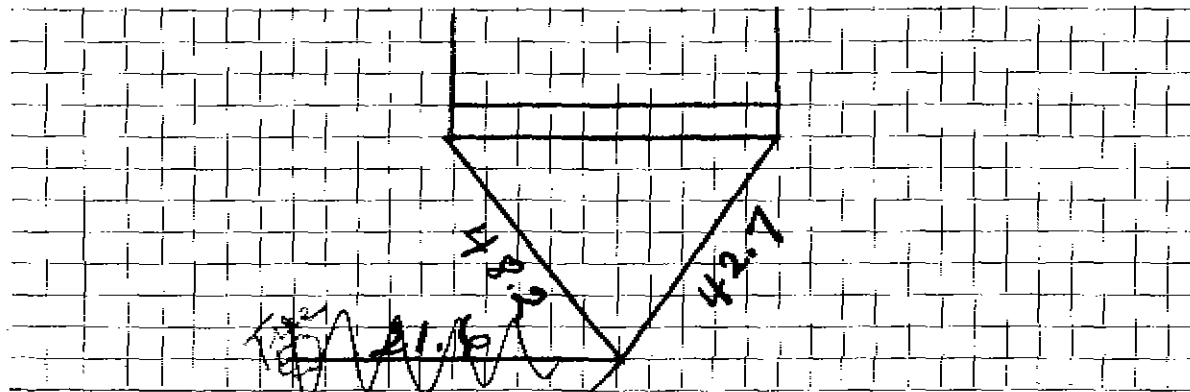


Connection made in _____

17-3 Street.

Work completed _____

19 _____

Remarks:

SMH  under hot top