


DATE _____

TOWN OF LEXINGTON — BOARD OF PUBLIC WORKS

WATER DIVISION

Sketch of Service Here

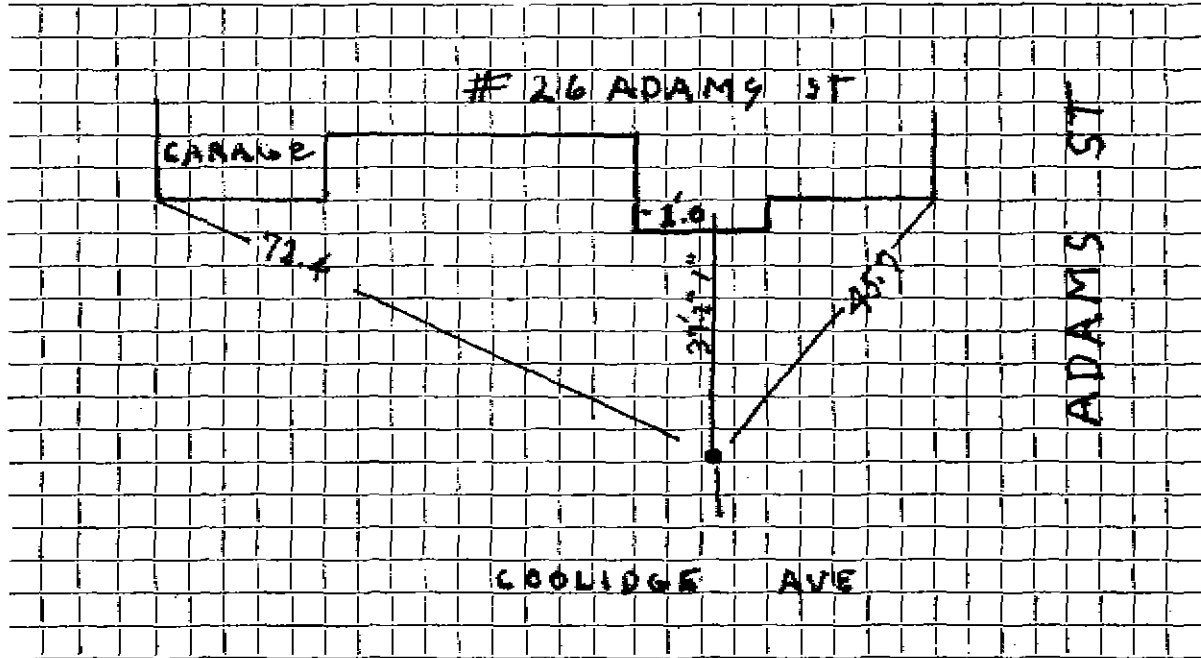

Connection made in COOLIDGE AVE Street. Work completed

Remarks: WAS 5 COOLIDGE AVE