

Name John H. Brooks  
 Address 29 Adams Street  
 Lexington, Mass.

Service No. 1-8

# 2080 #6615  
 #4122

Location 29 Adams Street

Kind of Pipe

Size

Size of Main

~~Repair~~ ~~Extension~~ New Service

Com. 9-26-49

Location

Date	Material	Amount	Total	Date	Material	Amount
Sept. 14, '49	Labor	4 90	4 90	Aug 18 '49	Reported	65 00
	10% Overhead		49	Charged	Revised	
	63' - 3/4" Copper Tubing @.24	15 12			No Charge	46 94
	1 - 3/4" C x 1/2" I.W.H. S&W	3 29		Sept. 14, '49	Labor	4 90
	1 - 3/4" C x 3/4" C Union (3pts)	1 39			15' - 3/4" Copper Tubing @.24	3 60
	Trucking 1 hr. @.75	7 00	75		1 - 3/4" C Corp-cock	3 15
	Littlefield Shovel 3 hrs. @	21 00	21 00		1 - 3/4" C x 3/4" C Curb-cock	3 85
			46 94		1 - Box & Rod	3 75
					Littlefield Shovel 1 hr. @7.00	7 00
					1 - 1/2" Offset Tail Piece	37
					1 - 1/2" Straight Tail Piece	37
					Trucking 1 hr. @.75	75
	Labor					27 74

TOWN OF LEXINGTON - BOARD OF PUBLIC WORKS

**WATER DIVISION**

The undersigned applies for a supply of water at No..... St. and hereby agrees to comply with the rules and regulations as now, or at any future time, established by the Board of Selectmen.

Am't of Estimate \$.....

Owner .....


Am't Paid \$.....

Address .....

Builder .....

.....

Sketch of Service Here

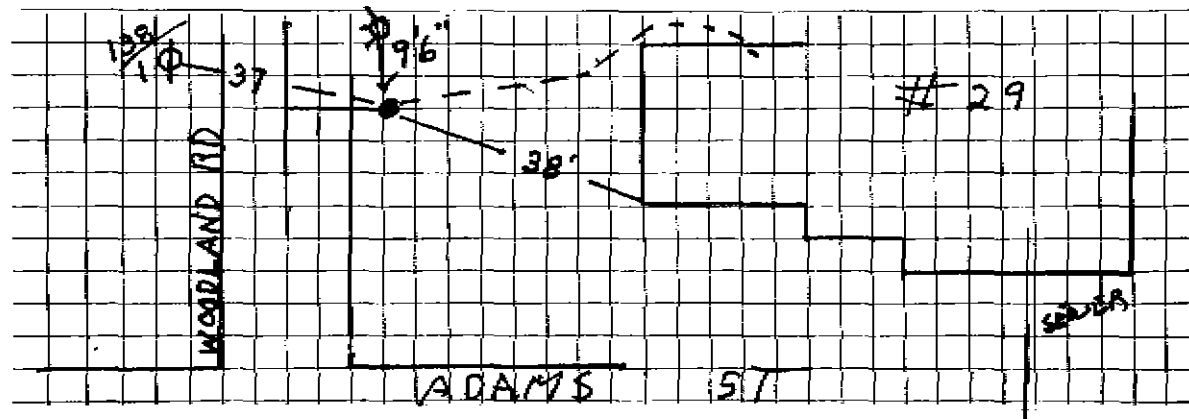

Connection made in ..... Street.

Work completed .....19

Remarks: