

WATER SERVICE RECORD

#903

Name Evelyn Beauchesne

Service No. 146

Address 32 Adams Street

Location

~~Repair - Rework~~ - New Service W.C. #8361

JUN 29 1964


Date	Material	Amount	Total	Date		Amount
3/17/64	Labor	2 05		12-4-63	Repair P	100 00
	10% O.H.	21	2 26	6-29-64	Retrod	48 00
	98' 3/4" Copper Tubing @ .42		41 16			52 00
	1 3/4" C x 1/2 I.W.H. Stop & Waste		6 17			
	1 3/4" C3 Part Union		2 41	3/17/64	Labor	2 13
			52 00		10' 3/4" Copper Tubing @ .42	4 20
					1 3/4" C Corp Cock	4 91
					1 3/4" C Curb Cock	6 28
					1 Bow & Rod	4 90
					1 1/2 Straight Tailpiece	50
					1 1/2 Offset Tailpiece	50
						23 42

DATE _____

TOWN OF LEXINGTON — BOARD OF PUBLIC WORKS

WATER DIVISION

Sketch of Service Here

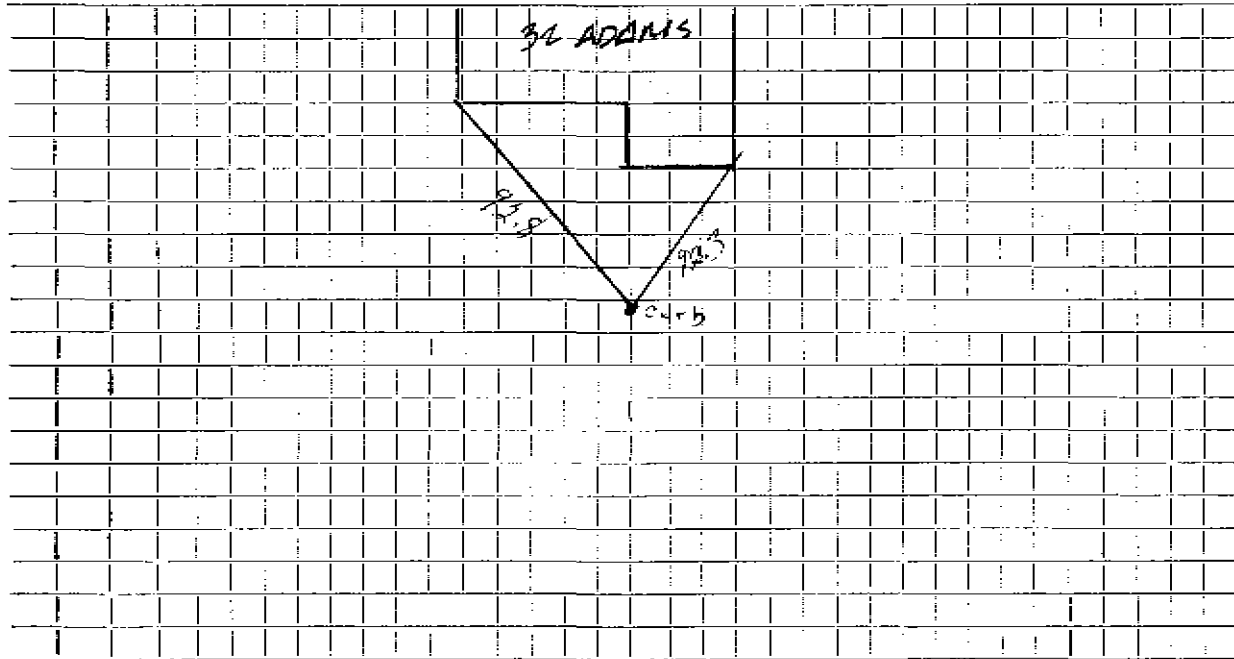

Connection made in Street. Work completed

Remarks:

.....
.....