

WATER SERVICE RECORD

364

Name George Graves

Service No. 50

Address 33 Adams Street

Location

~~Water General~~ - New Service W.O. #8021

Comm 10-28-63

Date	Material	Amount	Total	Date		Amount
6/18/63	Labor	2 13		6-12-63	Deposit	50 00
	10% Overhead	21	2 34	6-28-63	Refund	8 42
	73' - 3/4" Copper Tubing @ .42		30 66			41 58
	1 - 3/4" Cx 1/2 I.W.H. Stop & Waste		6 17		NON CHARGE	
	1 - 3/4" C 3-part Union		2 41		Labor	1 60
			41 58		9' - 3/4" Copper tubing @ .42	3 78
					1 - 3/4" C. Corp Cock	4 91
					1 - 3/4" C. Curb Cock	6 28
					1 Box & Rod	4 90
					1 1/2 Straight Tailpiece	50
					1 1/2 Offset Tailpiece	50
						22 47


DATE _____

TOWN OF LEXINGTON — BOARD OF PUBLIC WORKS

WATER DIVISION

Sketch of Service Here

#33 ADAMS ST

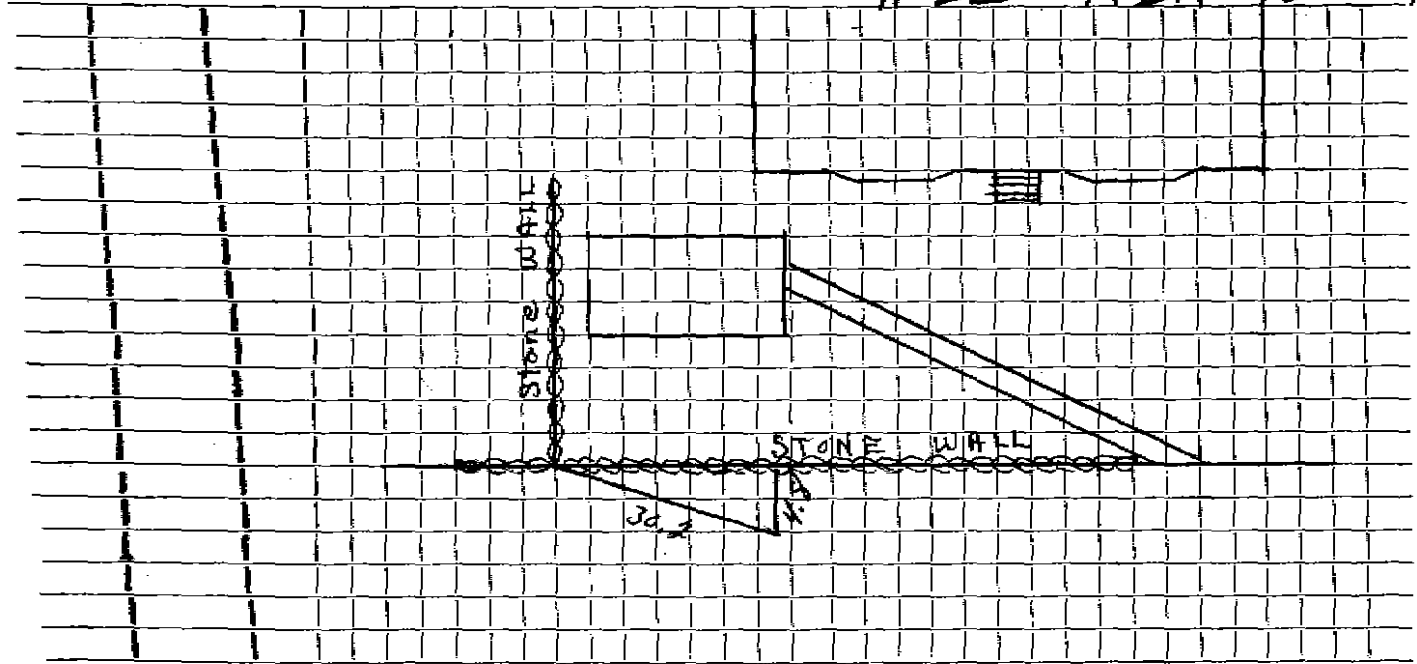

Connection made in _____ Street. Work completed _____

Remarks: ..S&M .. AS .. OLD .. TIE ..

..... TIE .. PUT .. IN .. SO .. LONG .. AGO .. THERE .. WAS .. NO .. DATE ..