

WATER SERVICE RECORD

#4283

Name Joseph Beauchesne

Service No. 119

Address 36 Adams Street

Location Lexington, Mass.

Repair —  Renewal —  New Service


Sum 7-24-51

Date	Material	Amount	Total	Date	Material	Amount
7-16-51	Labor	6 79	6 79	6-25-51	Deposited	45 00
	10% Overhead		68	9-24-51	Refunded	2 48
	50'-3/4" Copper Tubing @.326	16 30				
	1-3/4" Cx 1/2" I.W.H. S&W	4 00			No Charge	
	2 Hr. Littlefield Shovel @7.00	14 00		7-16-51	Labor	20 13
	1 Hr. Trucking		75		15'-3/4" Copper Tubing @.326	4 89
			42 52		1-3/4" C. Corp-Cock	4 33
					1-3/4" Cx3/4" C Curb-Cock	4 67
					1 Box & Rod	4 68
					1-1/2" Offset Tail Piece	50
					1-1/2" Straight Tail Piece	50
					2 2/3 Hr. Littlefield Shovel	18 66
					1 Hr. Trucking	75
					Patching (9x3)	9 00
						68 11

DATE \_\_\_\_\_

TOWN OF LEXINGTON — BOARD OF PUBLIC WORKS  
WATER DIVISION

Sketch of Service Here  
30 ADAMS

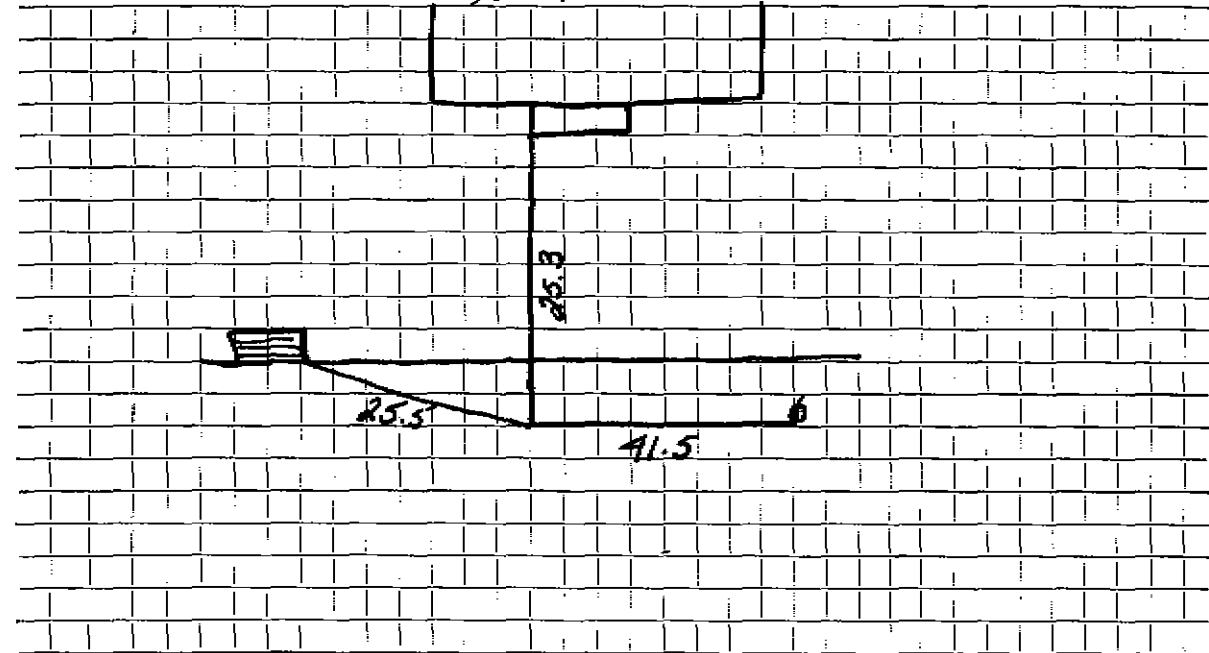

Connection made in ..... Street. Work completed .....

Remarks: .....  
.....  
.....