


DATE DEC 1984

TOWN OF LEXINGTON — BOARD OF PUBLIC WORKS

WATER DIVISION

Sketch of Service Here

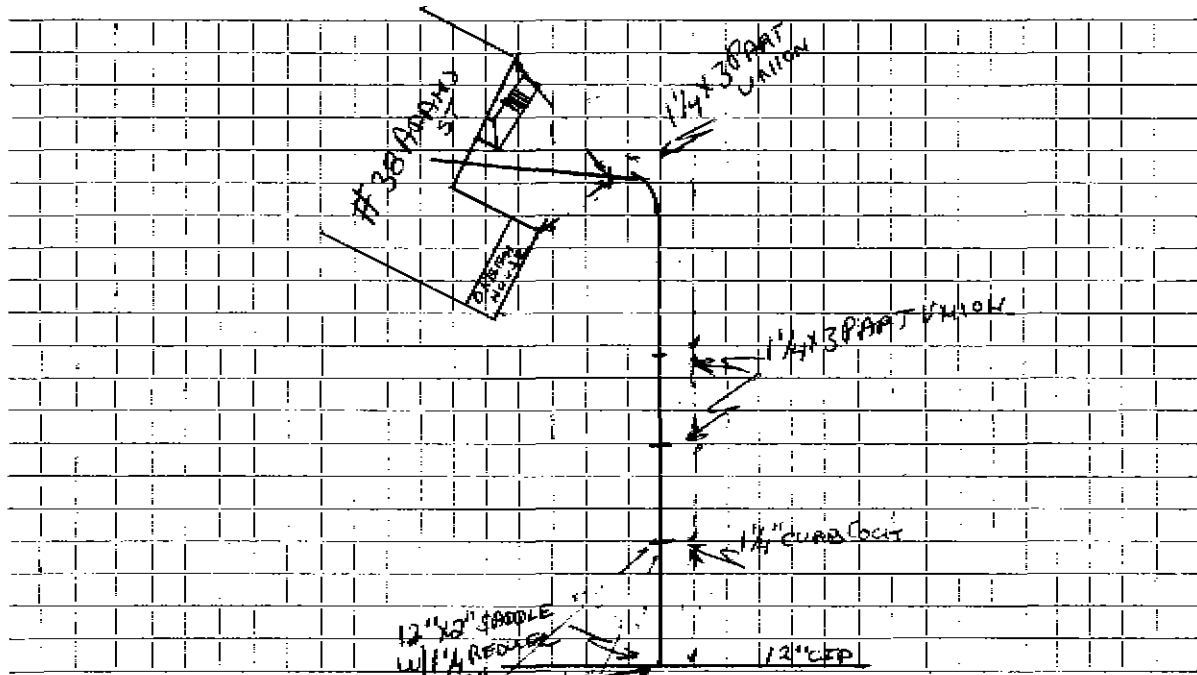

Connection made in ADAMS ST Street. Work completed DEC 15, 1984

Remarks:

.....

.....