

WATER SERVICE RECORD

#3744

Name A. C. Warren

Service No. 100

Address 39 Adams Street

Location

~~Repair~~ ~~Renewal~~ ~~New Service~~

Comm 4-13-61


Date	Material	Amount	Total	Date	Amount
8-29-61	Labor	4.08		7-17-61	Deposit 100.00
	10% O.H.	.41	4.49	11-13-61	Returned 24.09
	108' 1" Copper tubing @.56		60.48		75.91
1	1" x 3/4" I.W.H. Stop & Waste		6.96		NON CHARGE
1	1# 3 part union		3.98	8-29-61	Labor 3.78
			75.91		15' 1" Copper tubing @.56 8.40
					1 1" C Corp Cock 7.31
					1 1" C Curb Cock 8.06
					1 box & rod 4.90
					1 3/4" Straight tailpiece .50
					1 3/4" Offset tailpiece .50
					33.45
					Applied to 54 C# 88

DATE _____

TOWN OF LEXINGTON — BOARD OF PUBLIC WORKS

WATER DIVISION

Sketch of Service Here

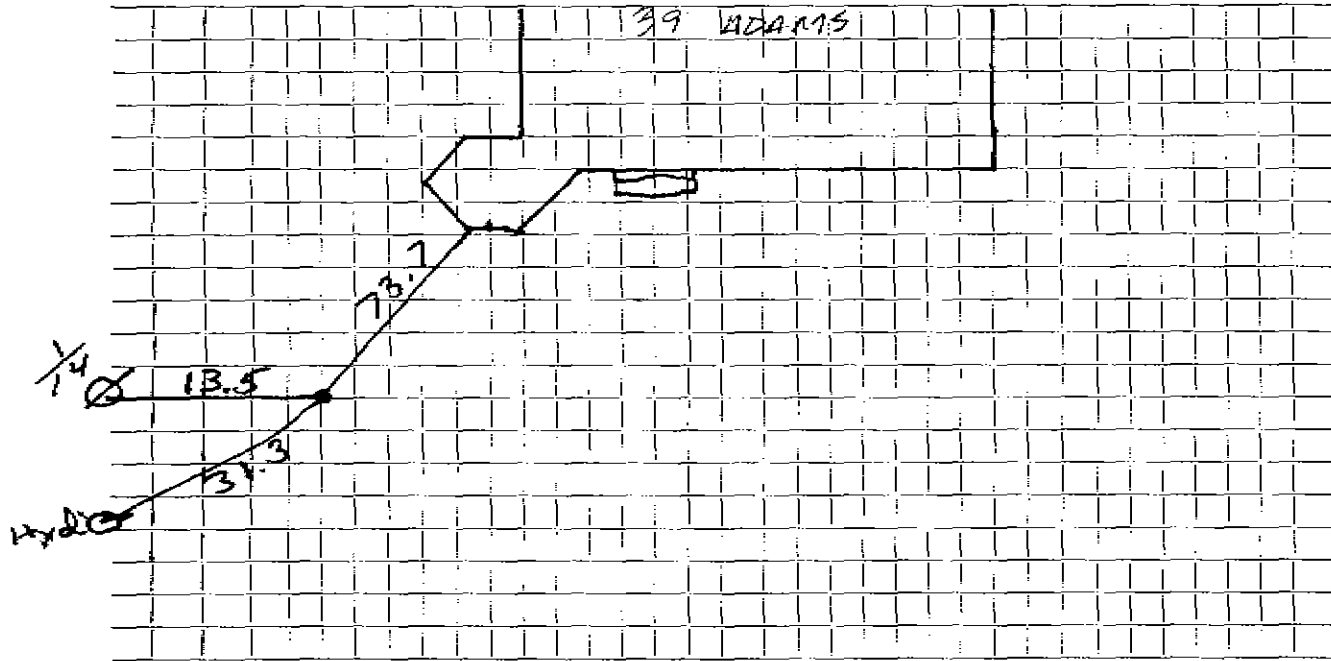

Connection made in Street. Work completed

Remarks:
.....
.....