

Name John Haskin

Service No. ~~24~~ 20

Address Adams Street

Location 45 Adams St

Kind of Pipe

Size

Size of Main

~~Repair~~ ~~Renewal~~ - New Service

Location

Date	Material	Amount	Total	Date	Amount
1937					
5/26/37	2 hrs. @ 60¢	1 20	1 20	May 27, 1937 Deposited	30 00
	54' Cop. Tub. @ 25¢		13 50		
	1 3/4" Galvanized C x 1" I. union		25		
	3 3/4" C. Unions @ 50¢		1 50		
	1 3/4" C. x 3/4" S. & W.		3 75		
	2 hrs. trucking @ 75¢		1 50		
			<u>21 70</u>		
	Say: 54' @ 50¢		27 00		
	Patching.		<u>3 00</u>		
			<u>30 00</u>		
	Labor				

Hadley Press, Inc., Lexington

DATE _____

TOWN OF LEXINGTON—BOARD OF PUBLIC WORKS

WATER DIVISION

The undersigned applies for a supply of water at No. 400 W. 5th St. and hereby agrees to comply with the rules and regulations as now, or at any future time, established by the Board of Selectmen.

Am't. of Estimate \$ 2,500


Owner _____

Am't. Paid \$ _____

Address 400 W. 5th St.

Builder _____

Sketch of Service Here

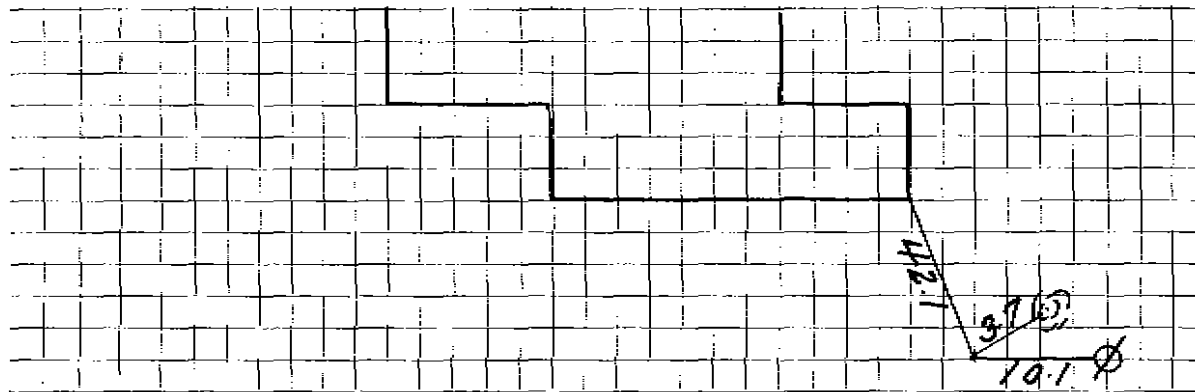

Connection made in _____ Street. Work completed _____ 19

Remarks: