


DATE _____

TOWN OF LEXINGTON — BOARD OF PUBLIC WORKS

WATER DIVISION

Sketch of Service Here

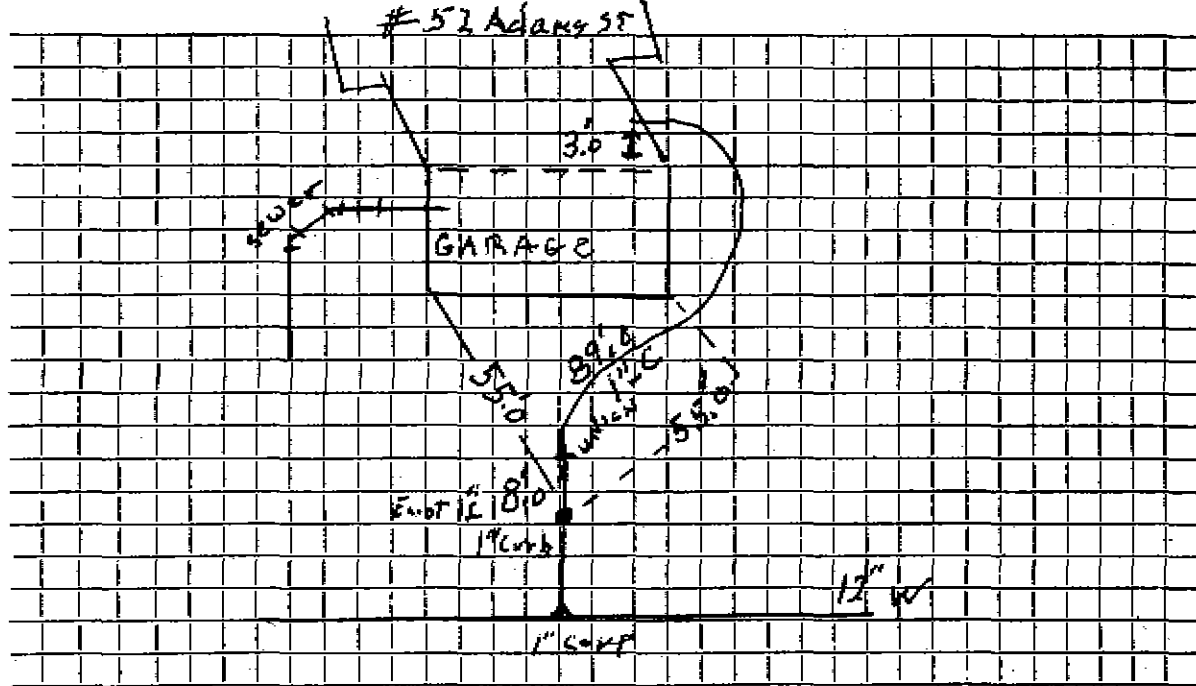

Connection made in Street. Work completed 4/7/06 J. McLaughlin.....

Remarks: 1998 - 8" W-AB. Service moved to 12" W - New 1" service......