

#5634

WATER SERVICE RECORD

Name Mary Rutledge

Service No. 162

Address 64 Adams Street

Location

Repair ~~Renewal~~ - New Service

Com. 8-30-54


| Date | Material | Amount | Total | Date | Amount |
|---------|---------------------------------------|--------|-------|--------------------------------|-------------------|
| 7/10/54 | Labor | 15 57 | | <i>7-5-54 Deposited</i> | 60 00 |
| | 10% overhead | 1 56 | 17 13 | <i>8-30-54 Refunded</i> | (6 92) |
| | 52' - 3/4" copper tubing @ .35 | | 18 20 | | <u>NON CHARGE</u> |
| | 1 - 3/4" C x 1/2" I.W.H. stop & waste | | 4 00 | 7/10/54 Labor | 23 00 |
| | 2 hrs. town shovel @ 5.00 | | 10 00 | 10' - 3/4" copper tubing @ .35 | 3 50 |
| | 1 hr. trucking | | 75 | 1 - 3/4" C. corp-cock | 4 33 |
| | patching 3 x 3 | | 3 00 | 1 - 3/4" curb-cock | 4 67 |
| | | | 53 08 | 1 box and rod | 3 90 |
| | | | | 1 - 1/2" offset tail piece | 50 |
| | | | | 1 - 1/2" straight tail piece | 50 |
| | | | | 1/2 hr. town shovel @ 5.00 | 2 50 |
| | | | | 1 hr. trucking | 75 |
| | | | | | <u>43 65</u> |

DATE _____

TOWN OF LEXINGTON — BOARD OF PUBLIC WORKS

WATER DIVISION

Sketch of Service Here

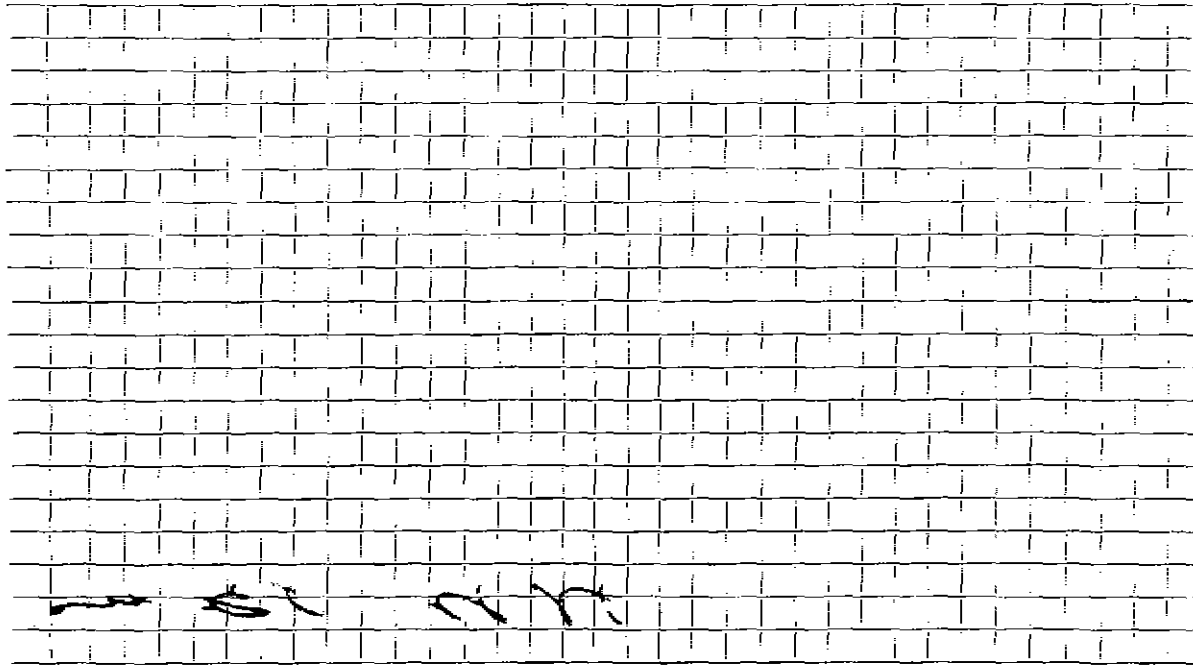

Connection made in Street. Work completed

Remarks:
.....
.....