

WATER SERVICE RECORD

#5118

Name Victor Scenna

Service No. 240

Address 68 Adams Street

#2215

Location

~~REPAIR~~ - New Service


*Comm. 11-8-54*

Date	Material	Amount	Total	Date	Amount
9/29/54	Labor	3 45		9-29-54 Deposited	50 00
	10% overhead	35	3 80	11-8-54 Refunded	2 45
	60' - 3/4" copper tubing@.35	21 00			<u>47 55</u>
	1 - 3/4" C x 1/2 I.W.H. stop&waste	4 00		9/29/54 Labor	3 45
	2 hrs. Littlefield shovel@ 7.50	15 00		12' - 3/4" copper tubing@.35	4 20
	1 hr. trucking	75		1 - 3/4" C. corp-cock	4 33
	patching 3 x 3	3 00		1 - 3/4" C. curb-cock	4 67
			<u>47 55</u>	1 box and rod	3 90
				1 - 1/2 offset tail piece	50
				1 - 1/2 straight tail piece	50
				1/2 hr. Littlefield shovel@7.50	3 75
				1 hr. trucking	75
					<u>26 05</u>

DATE \_\_\_\_\_

TOWN OF LEXINGTON — BOARD OF PUBLIC WORKS  
WATER DIVISION

Sketch of Service Here

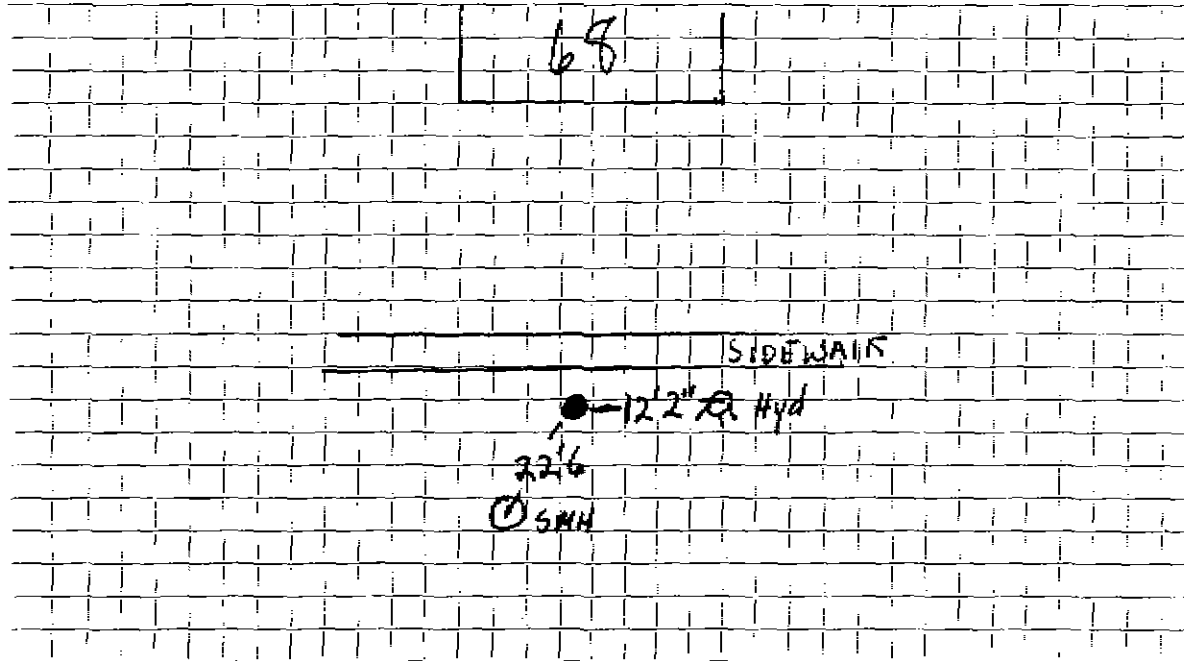

Connection made in ..... Street. Work completed .....

Remarks: .....

.....  
.....