

## WATER SERVICE RECORD

Name Mrs. Nathan Newbury, Jr.

Service No. 47

Address 7 Adams Street

Location

~~Repair~~ ~~Renewal~~ ~~New Service~~

Comm. 6-19-61


Date	Material	Amount	Total	Date	Amount	
5-9-61	Labor	41.40		4-21-61	150.00	
5-10-61	Labor	30.38	71.78	7-14-61	32.62	
	10% O.H.	7.18	78.96		182.62	
91'	1" Copper Tubing @.56		50.96	5-9-61	Labor	17.34
1	1" x 1" Comp. Valve		6.96	22'	1" Copper Tubing @.56	12.32
1	1" x 1" 3 part union		3.98	1	1" Adapter	3.29
8 $\frac{1}{4}$	Ton Gravel @.85		7.01	1	1" Curb Cock	8.06
2 $\frac{1}{2}$	Hr. Town Shovel @6.50		16.25	1	Box & Rod	4.90
3	Hrs. Trucking @3.00		9.00	$\frac{1}{2}$	Hr. Loader @3.00	1.50
1	Hr. Pippin @5.00		5.00	$\frac{1}{2}$	Hr. Shovel @6.50	3.25
1 $\frac{1}{2}$	Hr. Loader @3.00		4.50		20 x 3 Patch	20.00
			182.62			70.66

TOWN OF LEXINGTON — BOARD OF PUBLIC WORKS

WATER DIVISION

Sketch of Service Here

7 ADAMS

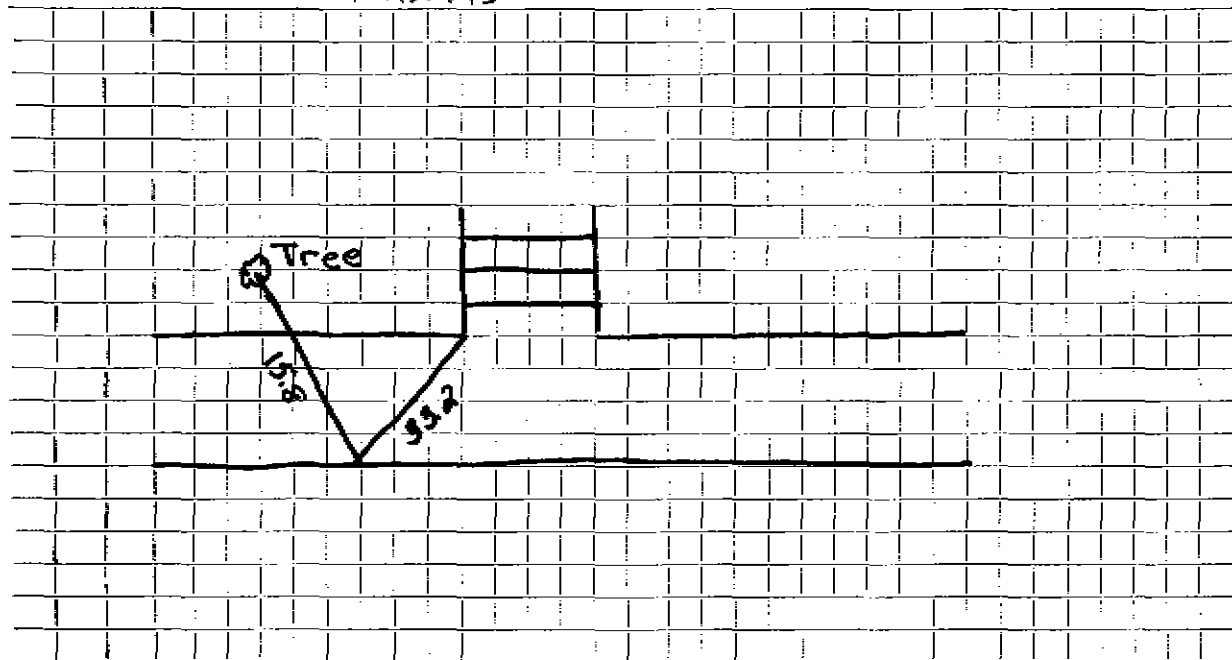

Connection made in ..... Street. Work completed .....

Remarks: .....

.....  
.....